SITE PLAN

ROBINSONS·MAY (EXISTING)

CEC #634
1 STORY, SECOND LEVEL
TENANT FINISH-OUT
14,806 SF

LEVEL 2 ENCLOSED MALL (EXISTING)

TARGET (EXISTING)

LEVEL 2 PARKING STRUCTURE (EXISTING)

GLENDALE (2) FREEWAY OFF RAMP

EL VERANO

COLORADO BLVD.

BROADWAY

LOCKHAVEN

SIERRA VILLA DR.

SIERRA VILLA DRIVE

ROCK GLEN AVENUE

NIAGARA WAY

GLENDALE ADVENTIST MEDICAL CLINIC

SITE INFORMATION

ZONING

PARKING

LANDSCAPING

NOTE

#634 - EAGLE ROCK, CA
WESTFIELD SHOPPINGTOWN EAGLE ROCK
2700 COLORADO BLVD. SUITE 224
LOS ANGELES, CA 90041

CEC ENTERTAINMENT, INC.
4441 WEST AIRPORT FREEWAY
IRVING, TEXAS 75062

CHUCK E. CHEESE'S

SITE PLAN

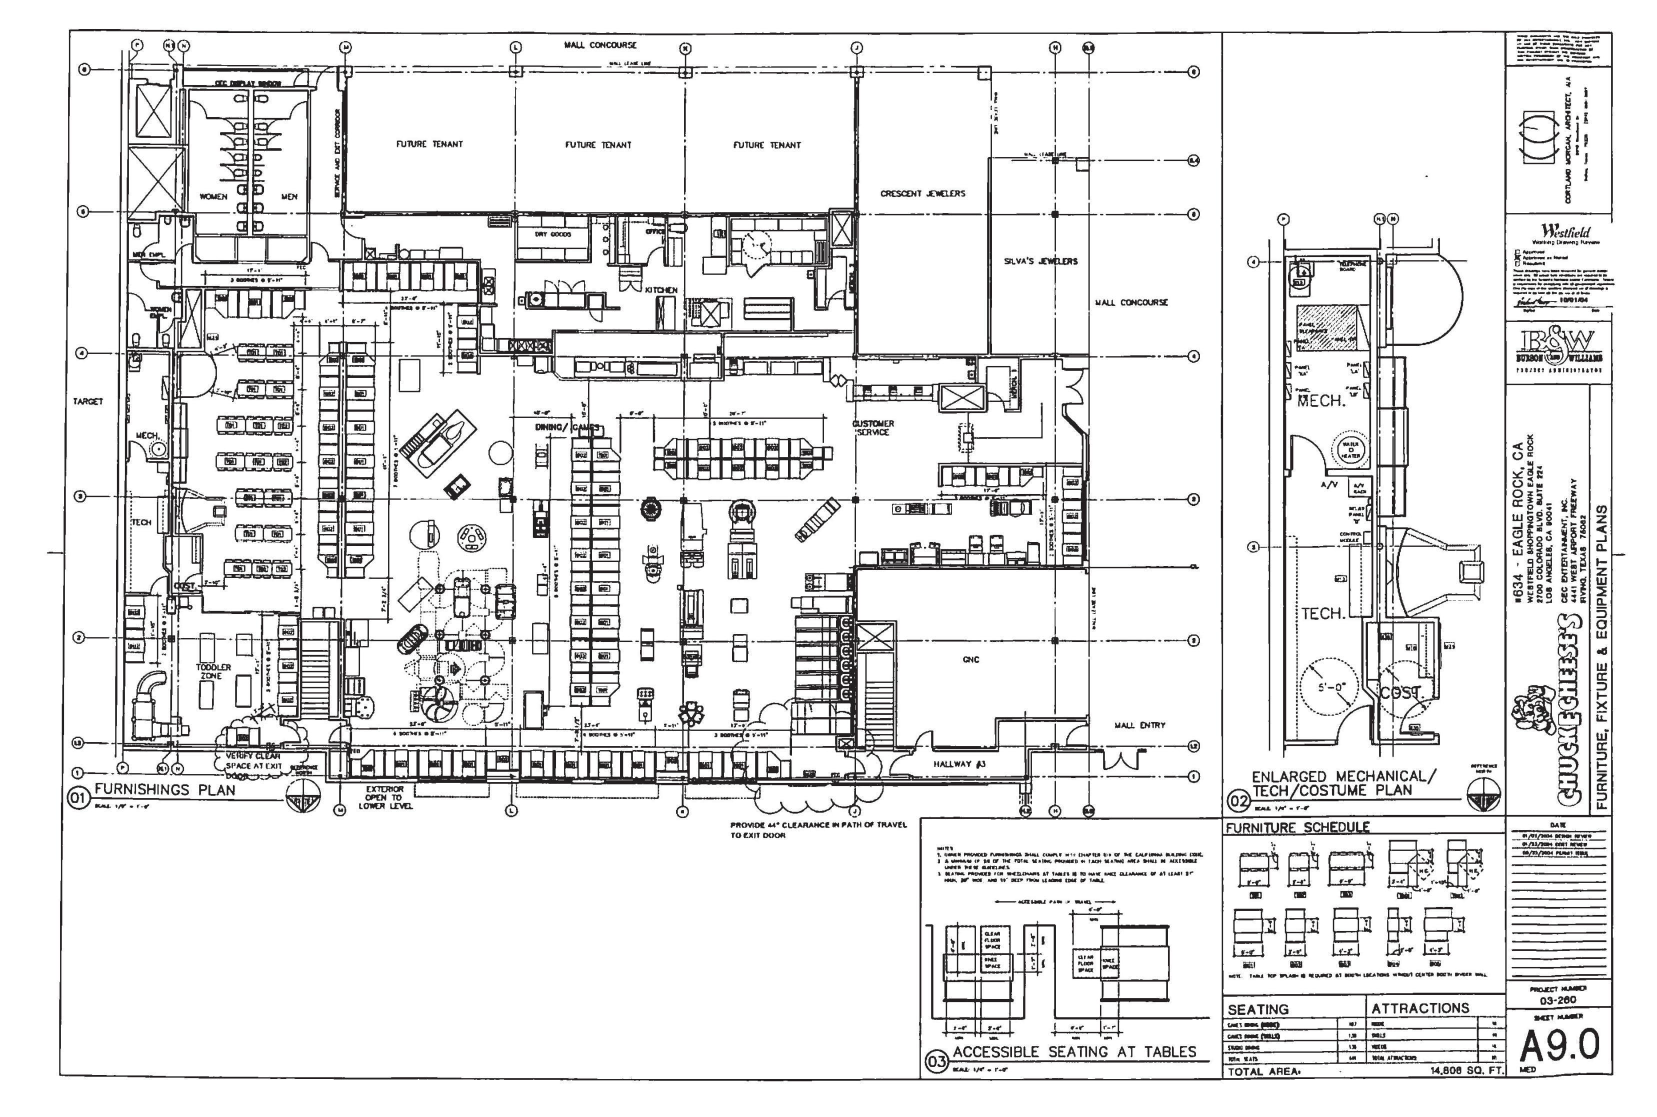
A0.0

CORTLAND MORGAN, ARCHITECT, AIA

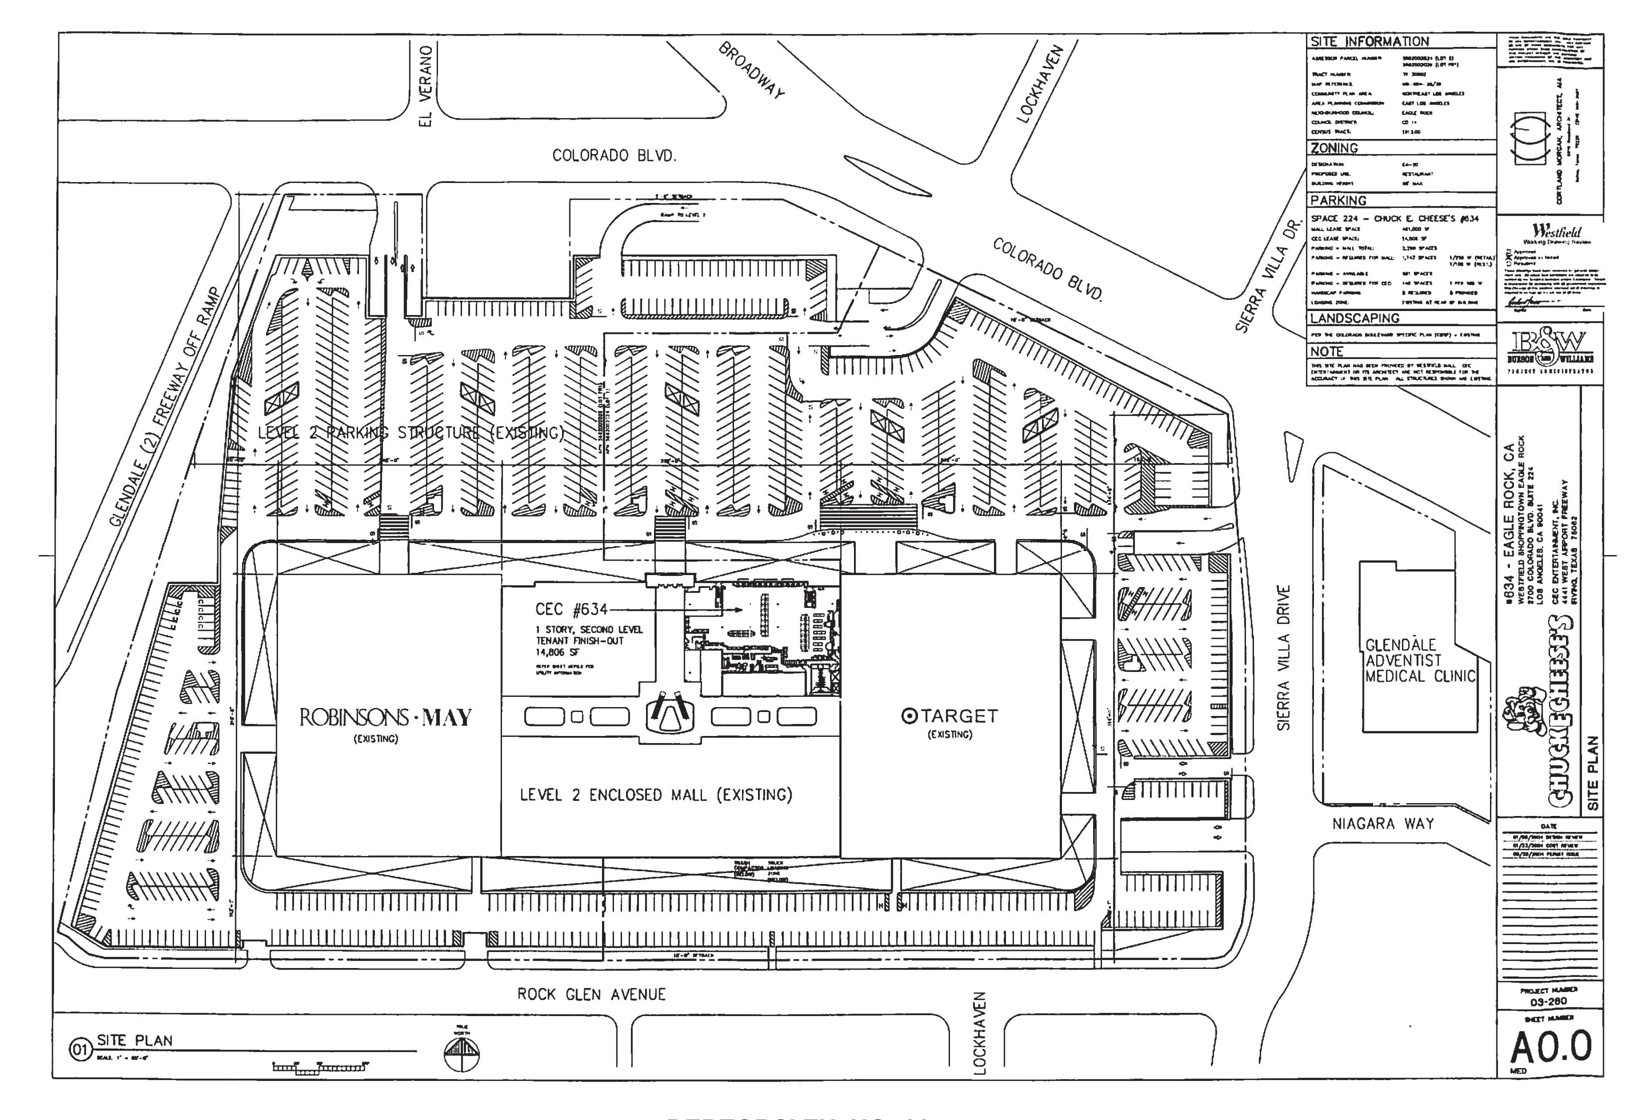
Westfield
Working Drawing Review

EXHIBIT G

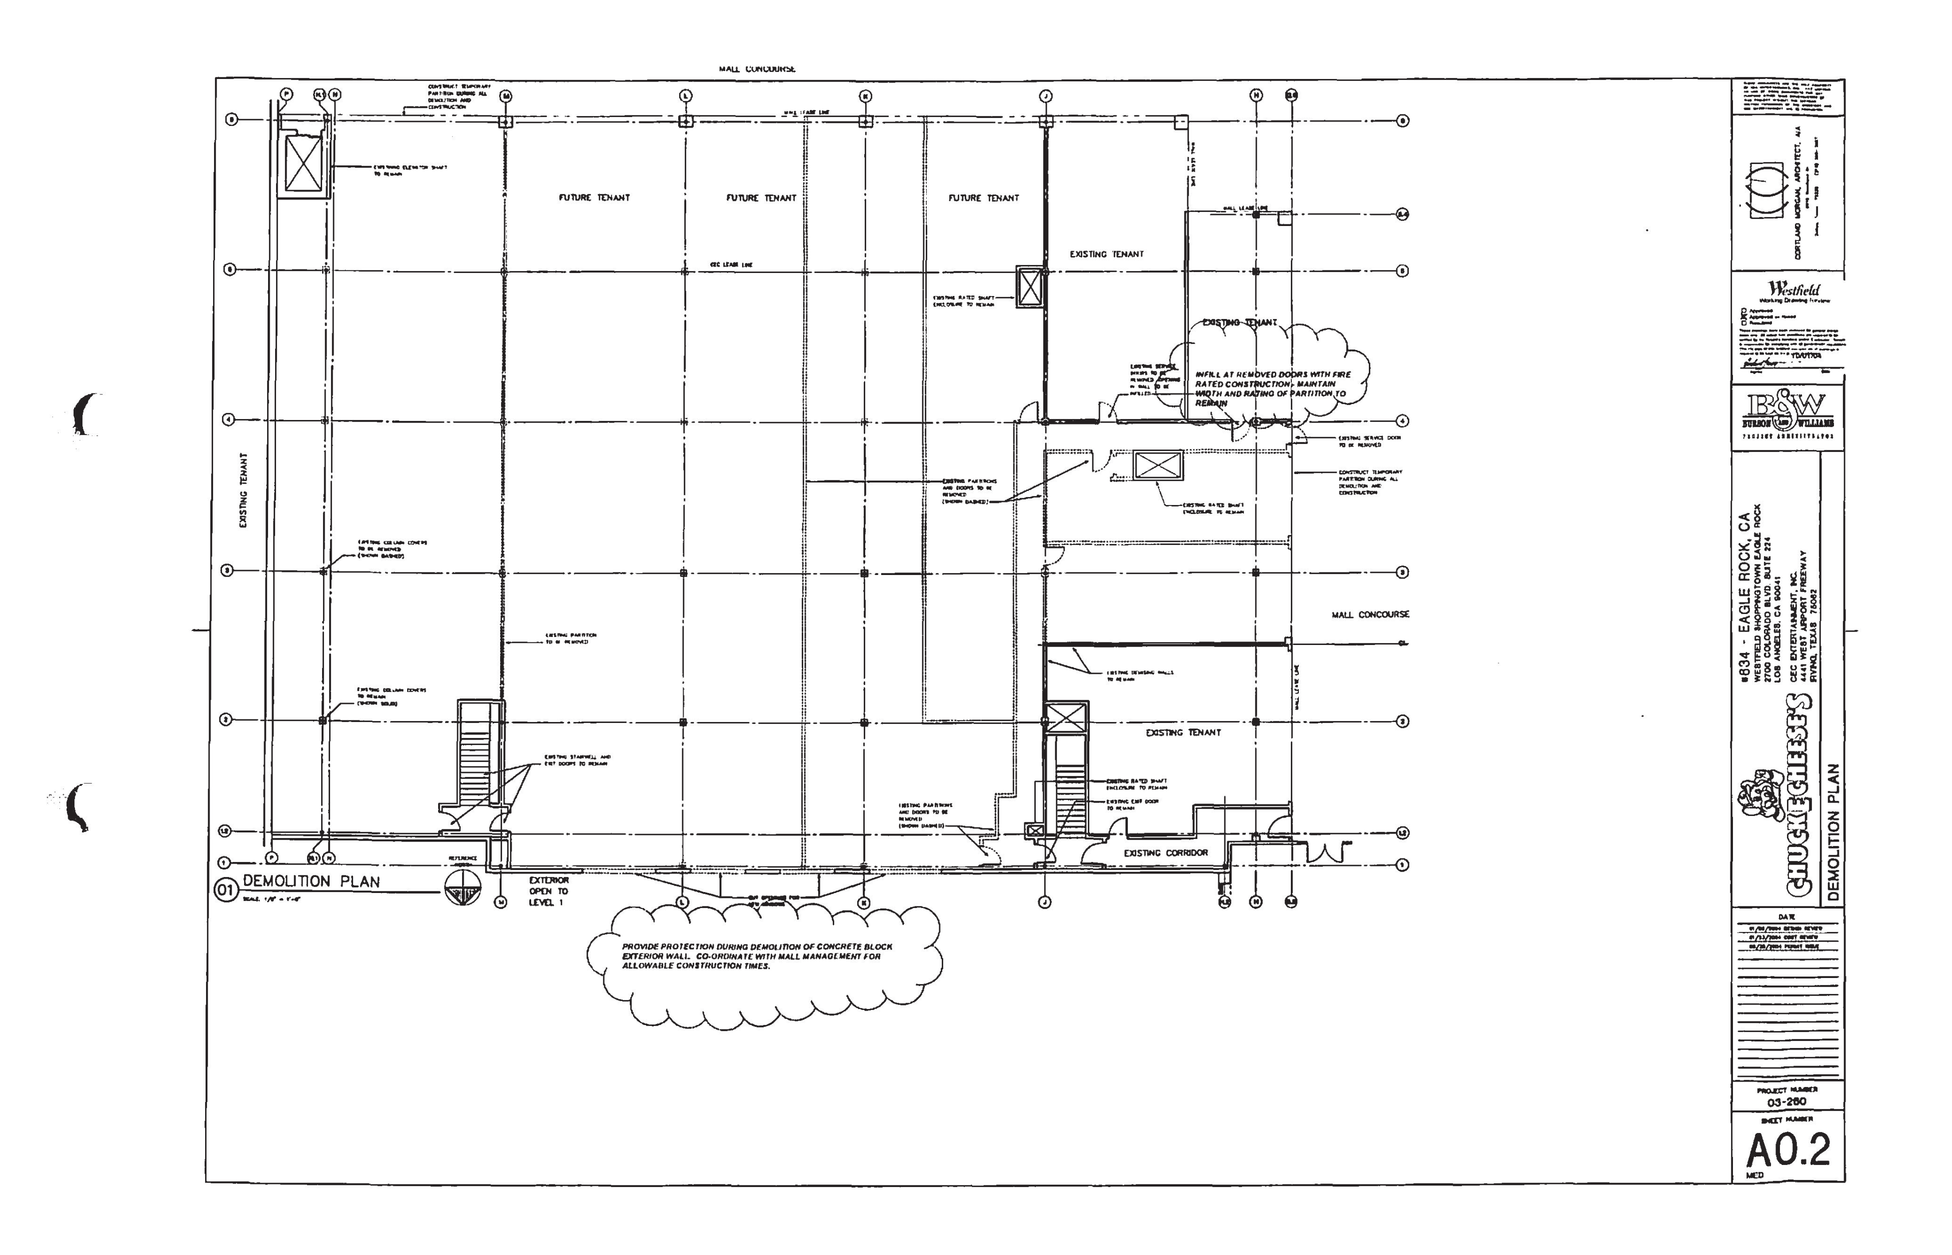
Final Working Drawings



DEBTORS' EX. NO. 11
Page 87 of 130



SITE INFORMATION
ZONING
PARKING
SPACE 224 - CHUCK E. CHEESE'S #634
LANDSCAPING
NOTE
CORTLAND MORGAN, ARCHITECT, AIA
Westfield
B&W
BURSON WILLIAMS
#634 - EAGLE ROCK, CA
WESTFIELD SHOPPINGTOWN EAGLE ROCK
2700 COLORADO BLVD. SUITE 224
LOS ANGELES, CA 90041
CEC ENTERTAINMENT, INC.
4441 WEST AIRPORT FREEWAY
IRVING, TEXAS 75062
CHUCK E. CHEESE'S
SITE PLAN
PROJECT NUMBER
03-260
SHEET NUMBER
A0.0
EL VERANO
BROADWAY
LOCKHAVEN
COLORADO BLVD.
COLORADO BLVD.
SIERRA VILLA DR.
GLENDALE (2) FREEWAY OFF RAMP
LEVEL 2 PARKING STRUCTURE (EXISTING)
CEC #634
1 STORY, SECOND LEVEL
TENANT FINISH-OUT
14,806 SF
ROBINSONS·MAY
(EXISTING)
TARGET
(EXISTING)
LEVEL 2 ENCLOSED MALL (EXISTING)
SIERRA VILLA DRIVE
GLENDALE ADVENTIST MEDICAL CLINIC
NIAGARA WAY
ROCK GLEN AVENUE
LOCKHAVEN
01 SITE PLAN


MALL CONCOURSE
FUTURE TENANT
FUTURE TENANT
FUTURE TENANT
EXISTING TENANT
EXISTING TENANT
EXISTING TENANT
EXISTING TENANT
INFILL AT REMOVED DOORS WITH FIRE RATED CONSTRUCTION; MAINTAIN WIDTH AND RATING OF PARTITION TO REMAIN
MALL CONCOURSE
EXISTING CORRIDOR
01 DEMOLITION PLAN
EXTERIOR OPEN TO LEVEL 1
PROVIDE PROTECTION DURING DEMOLITION OF CONCRETE BLOCK EXTERIOR WALL. CO-ORDINATE WITH MALL MANAGEMENT FOR ALLOWABLE CONSTRUCTION TIMES.
CORTLAND MORGAN, ARCHITECT, AIA
Westfield
B&W
#634 - EAGLE ROCK, CA
WESTFIELD SHOPPINGTOWN EAGLE ROCK
2700 COLORADO BLVD. SUITE 224
LOS ANGELES, CA 90041
CEC ENTERTAINMENT, INC.
4441 WEST AIRPORT FREEWAY
IRVING, TEXAS 75062
CHUCK E CHEESE'S
DEMOLITION PLAN
DATE
PROJECT NUMBER
SHEET NUMBER
A0.2

PROVIDE SECTION AT DISPLAY WINDOW AND MALL BULKHEAD

Co-ordinate layout of lease line with mall management - verify 5" setback

MALL CONCOURSE

FUTURE TENANT

FUTURE TENANT

FUTURE TENANT

CRESCENT JEWELERS

SILVA'S JEWELERS

MALL CONCOURSE

SEE ENLARGED PLAN - 1/4 A1.1 FOR DIMENSIONS CO-ORDINATE EXACT SHAFT OUTLINE WITH GROUND FLOOR TENANT DRAWINGS

DEFINE PARTITION TYPE - NOT ON LEGEND, SECTION 04

WOMEN

MEN

SERVICE AND EXIT CORRIDOR

DRY GOODS

OFFICE

KITCHEN

Define - hatch partition break to N.I.C. shaft.

2-hour rated shaft, co-ordinate with ground floor tenant

TARGET

MECH.

TECH

DINING/ GAMES

CUSTOMER SERVICE

Verify

TODDLER ZONE

Co-ordinate storefront layout with mall management. Show setback dimension from neutral pier lease line

GNC

MALL ENTRY

HALLWAY #3

EXTERIOR OPEN TO LOWER LEVEL

01 DIMENSIONED FLOOR PLAN

GENERAL NOTES

PLAN NOTES

INTERIOR PARTITION LEGEND

08 FIREPROOFING DETAIL

02 FULL-HEIGHT PARTITION

03 TYPICAL PARTITION

04 PLUMBING PARTITION

05 LOW WALL

06 PLAN DETAIL

07 DRAFT STOP DETAIL

CORTLAND MORGAN, ARCHITECT, AIA

Westfield

B&W BURSON AND WILLIAMS

#634 - EAGLE ROCK, CA
WESTFIELD SHOPPINGTOWN EAGLE ROCK
2700 COLORADO BLVD, SUITE 224
LOS ANGELES, CA 90041

CEC ENTERTAINMENT, INC.
4441 WEST AIRPORT FREEWAY
IRVING, TEXAS 75062

CHUCK E. CHEESE'S

DIMENSIONED FLOOR PLAN

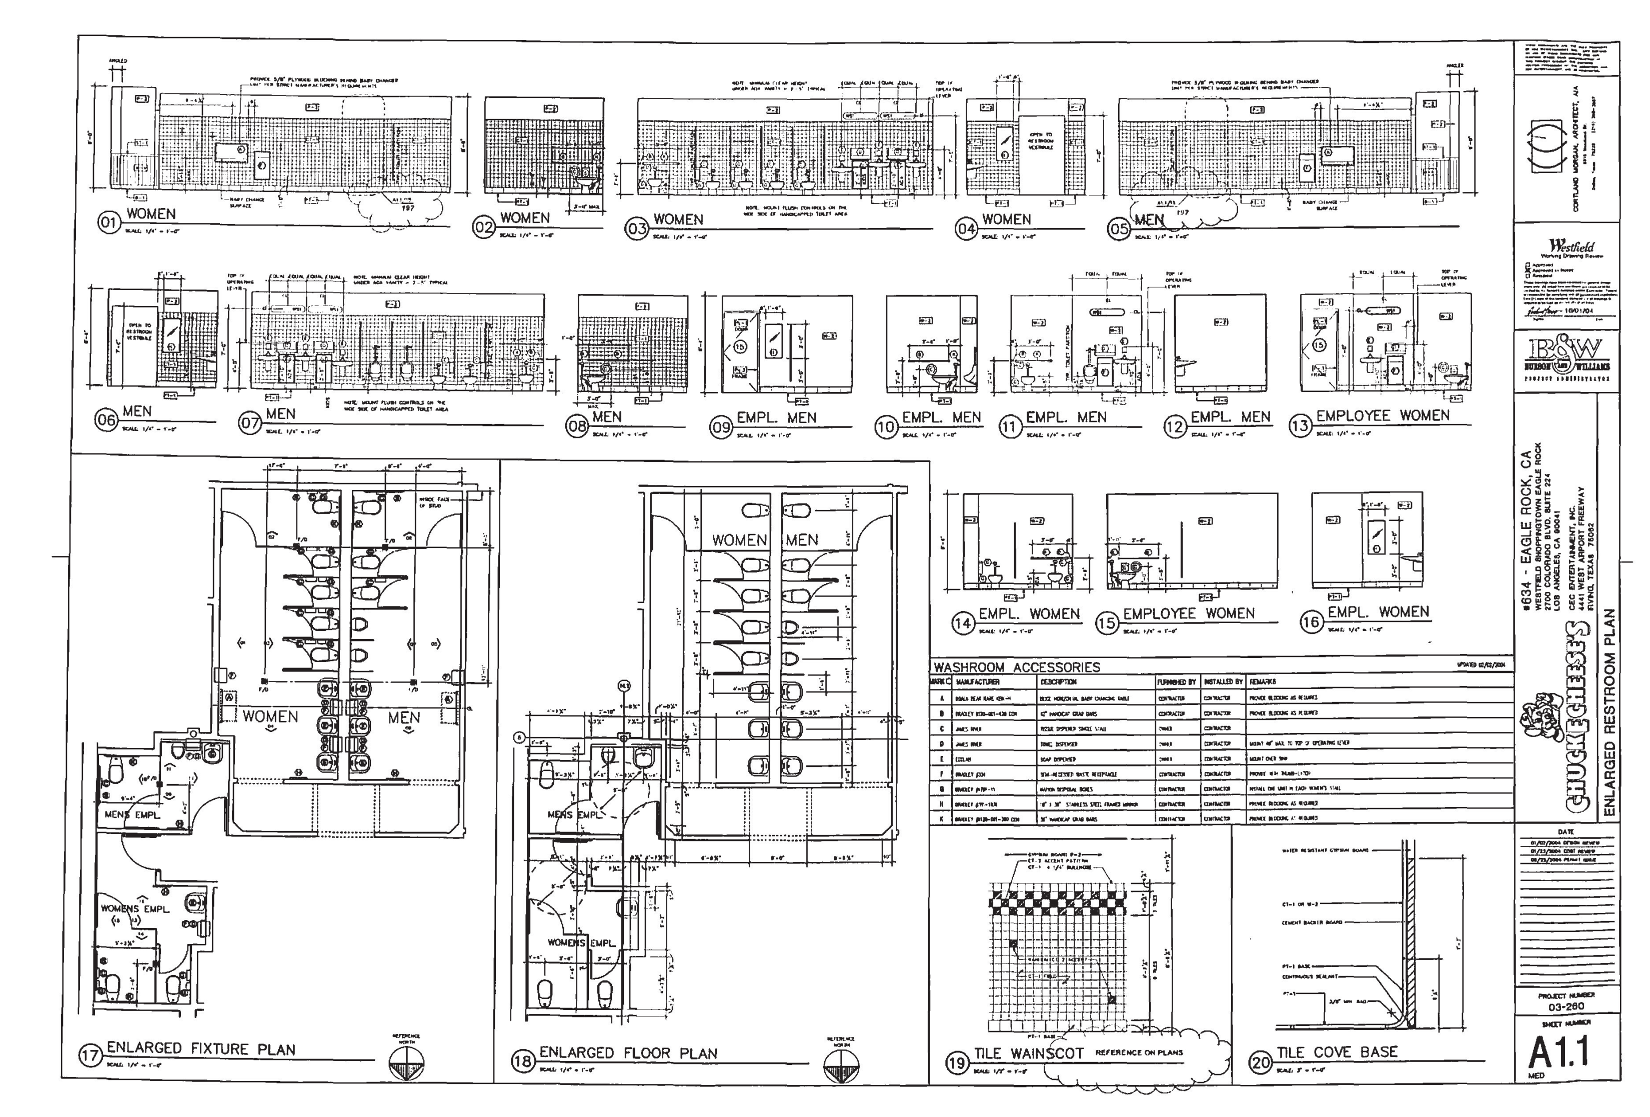
DATE

PROJECT NUMBER 03-260

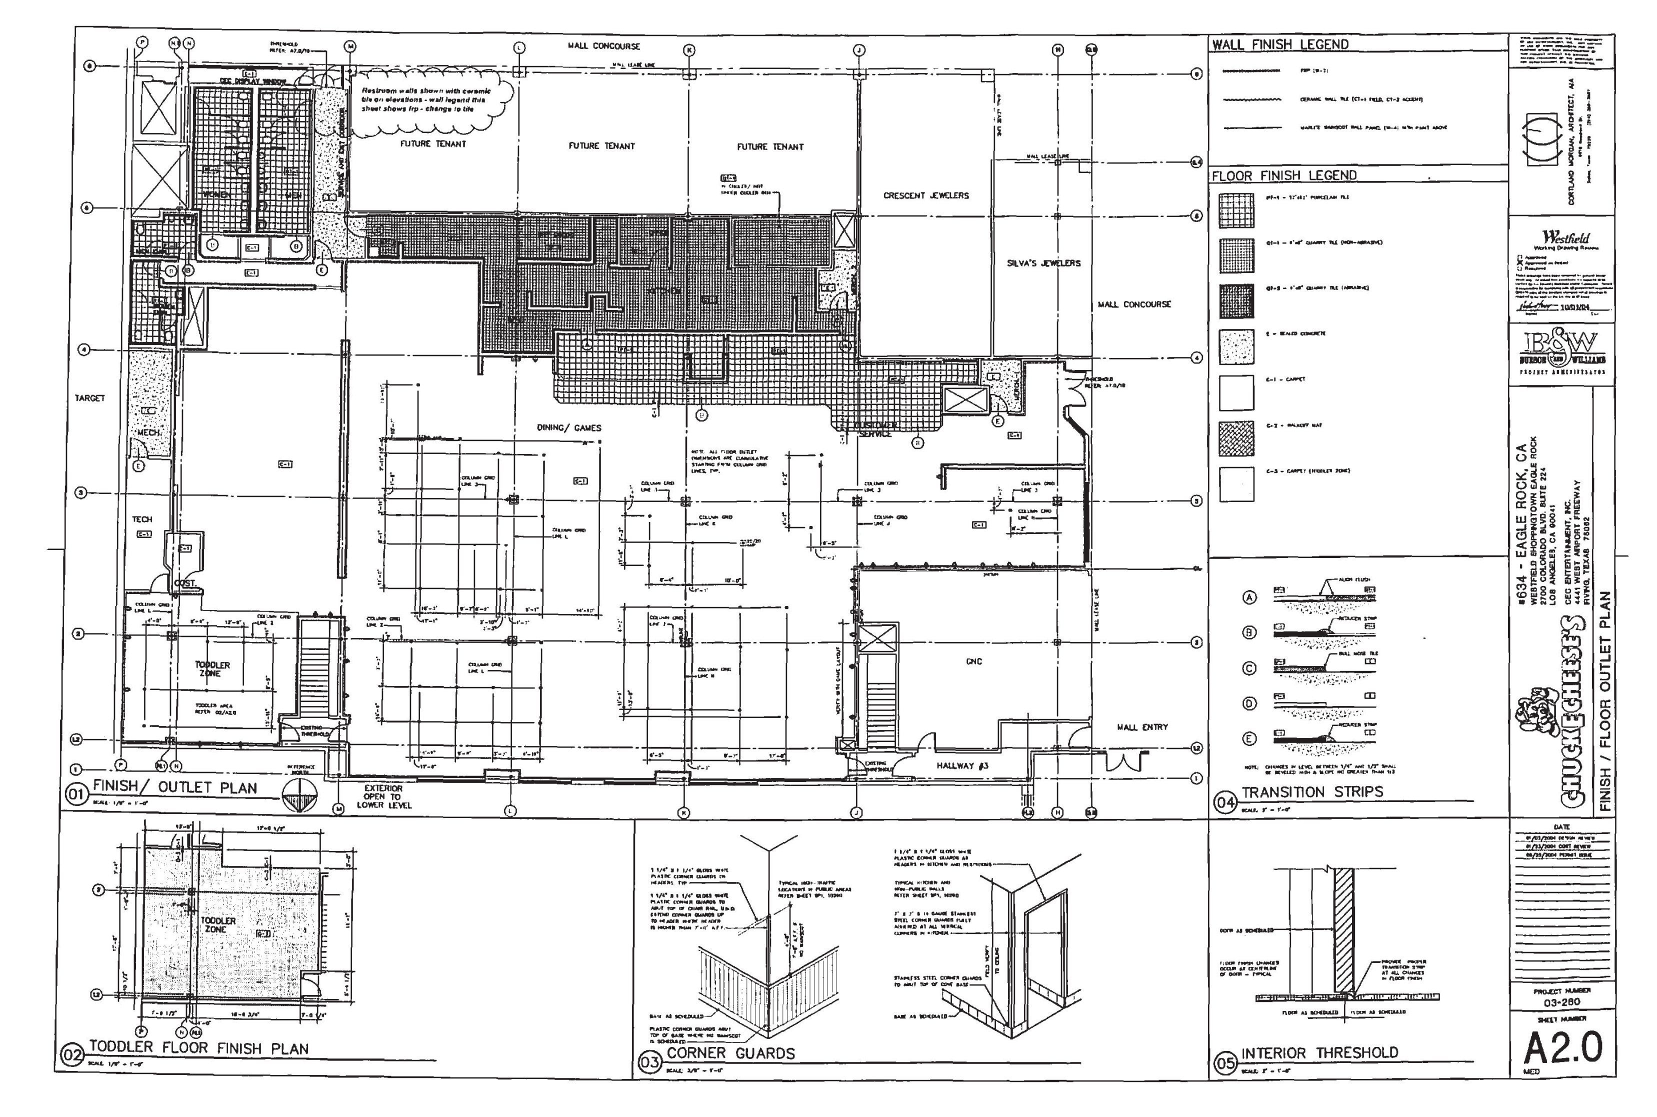


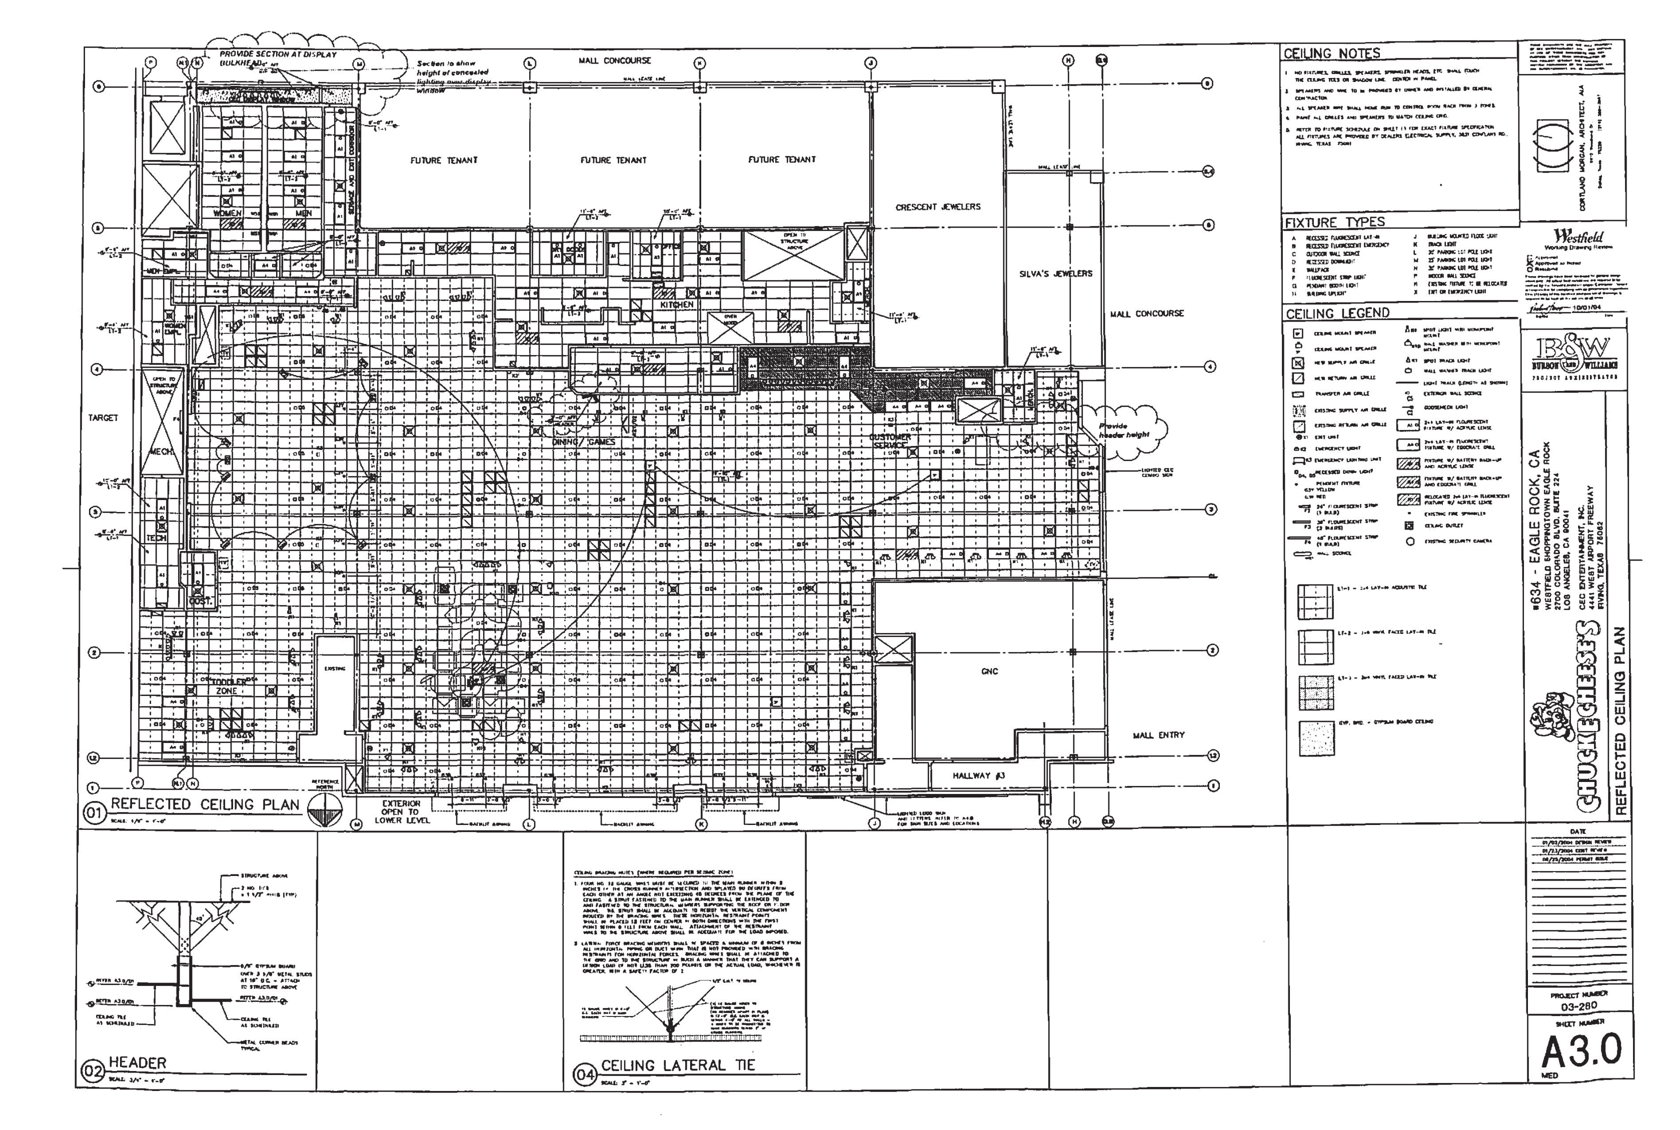
DEBTORS' EX. NO. 11
Page 90 of 130



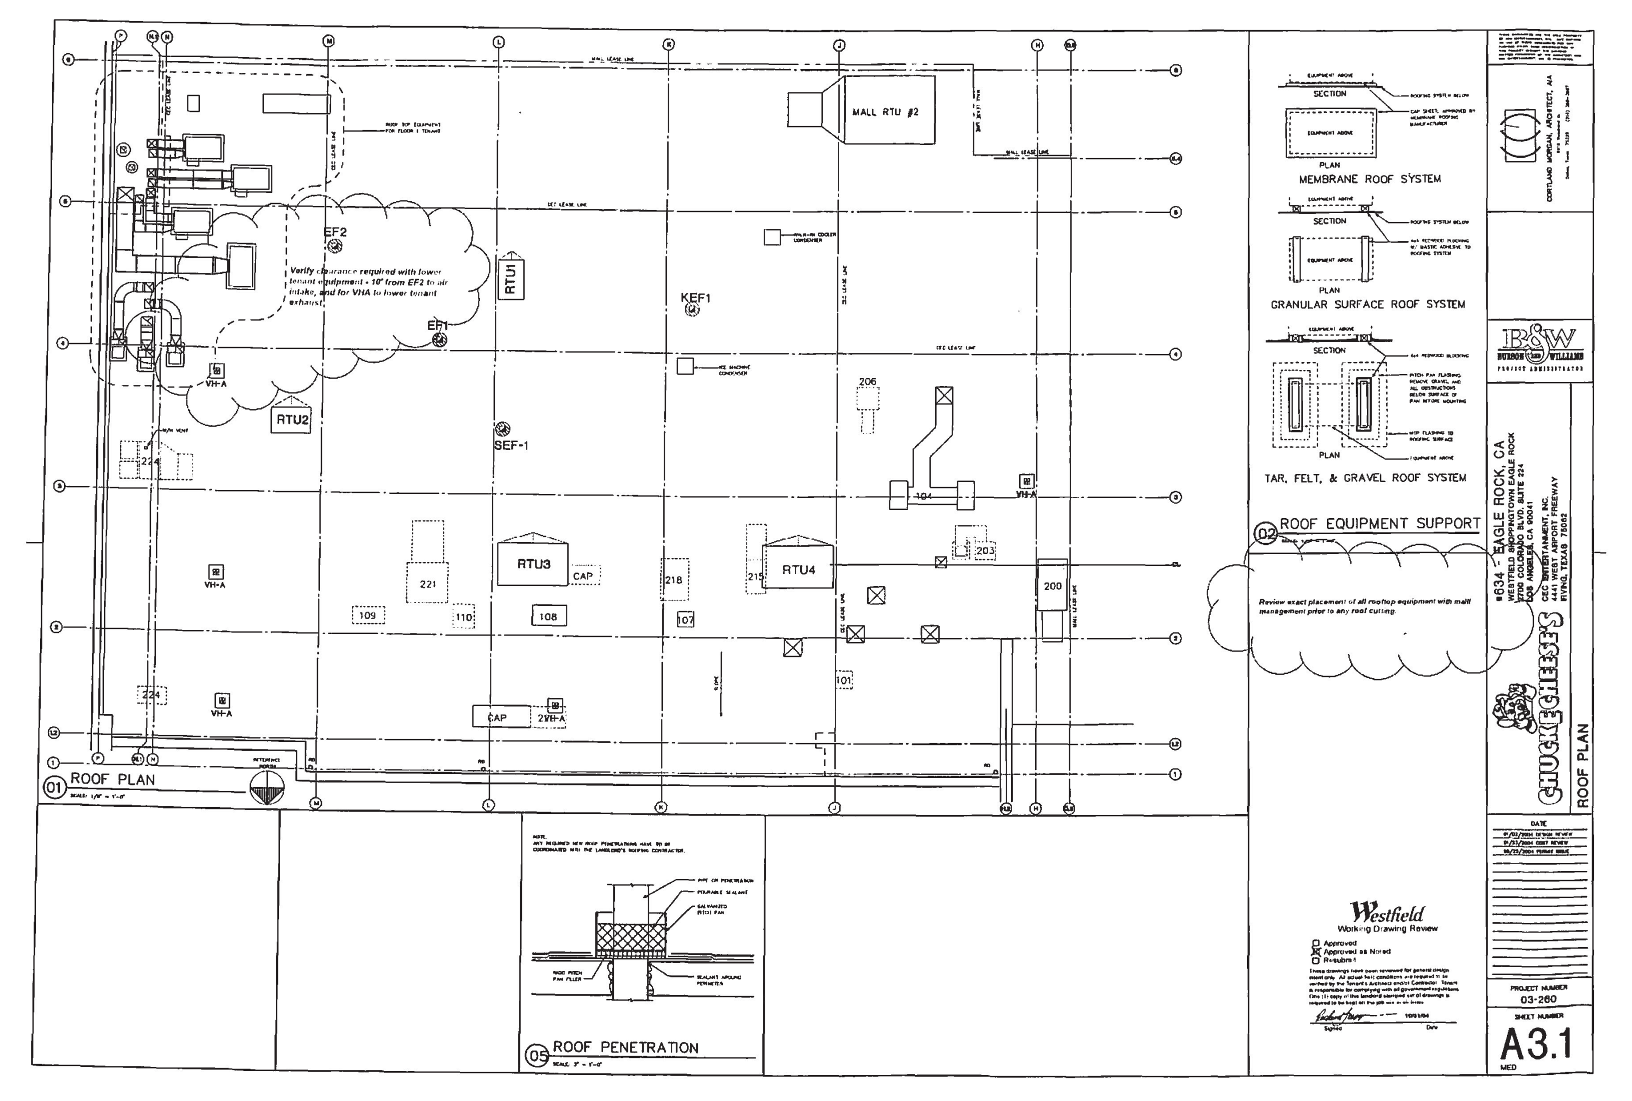
DEBTORS' EX. NO. 11
Page 91 of 130



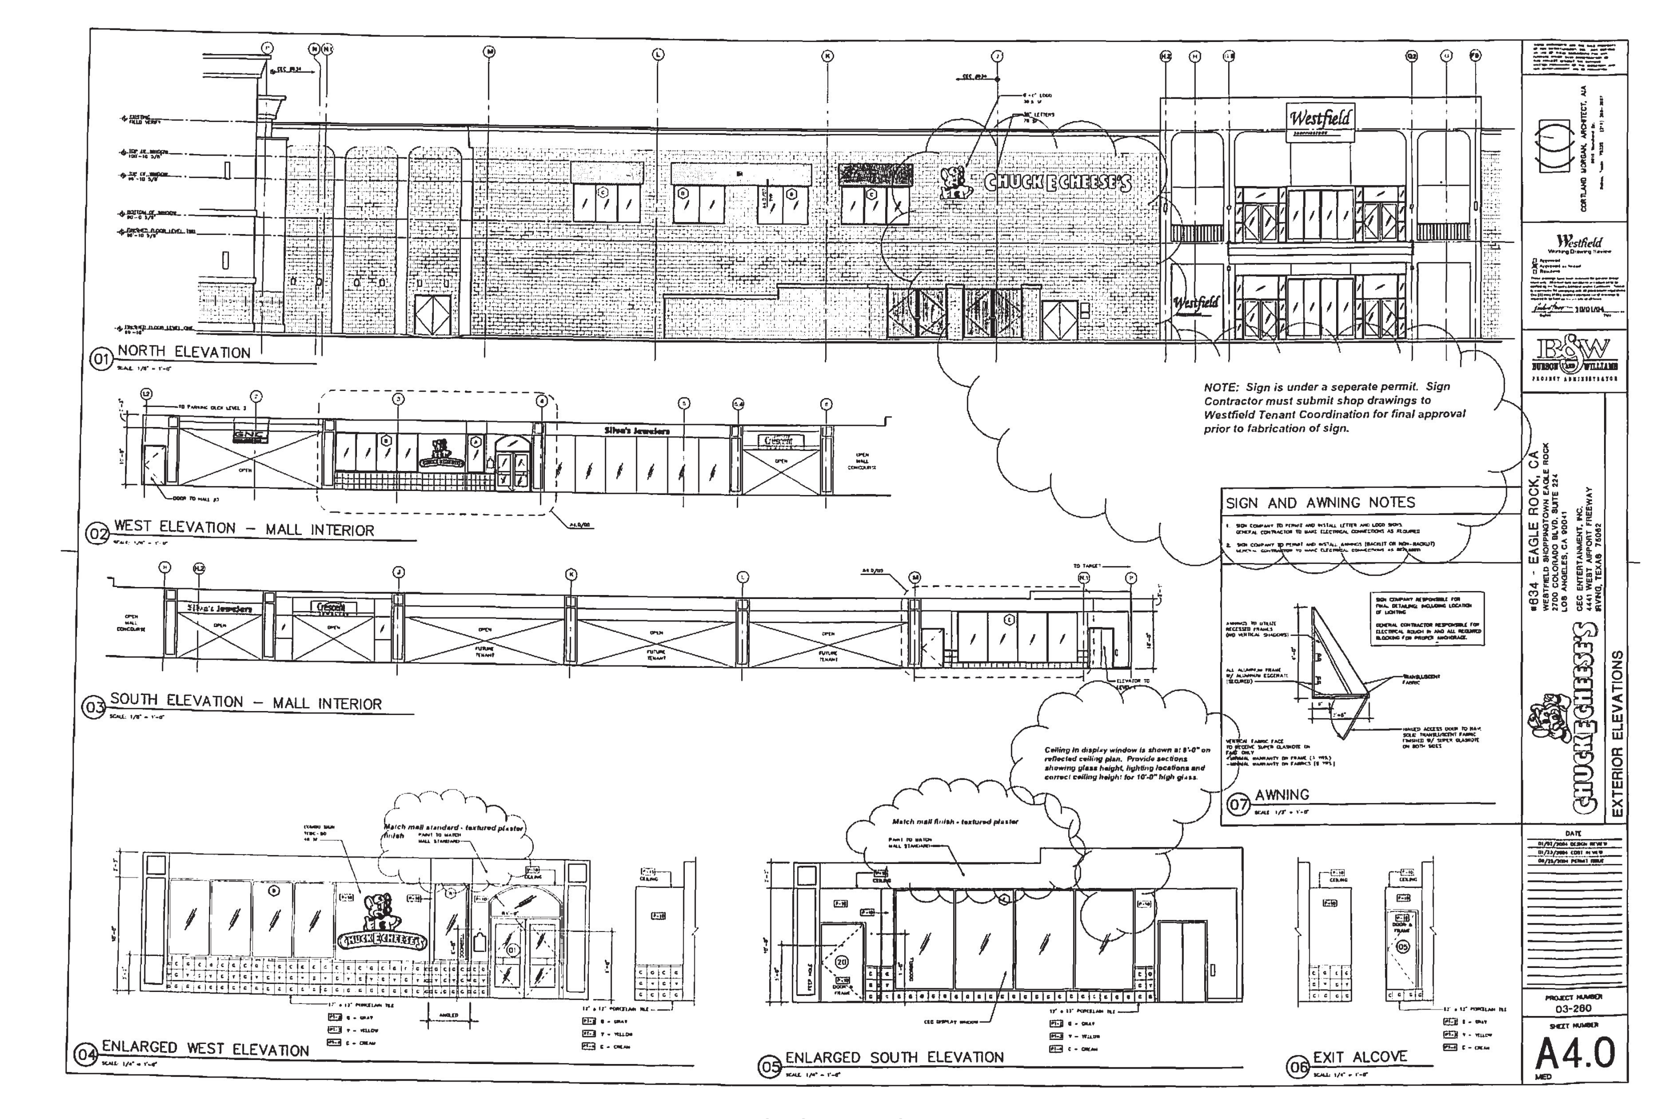
DEBTORS' EX. NO. 11
Page 92 of 130



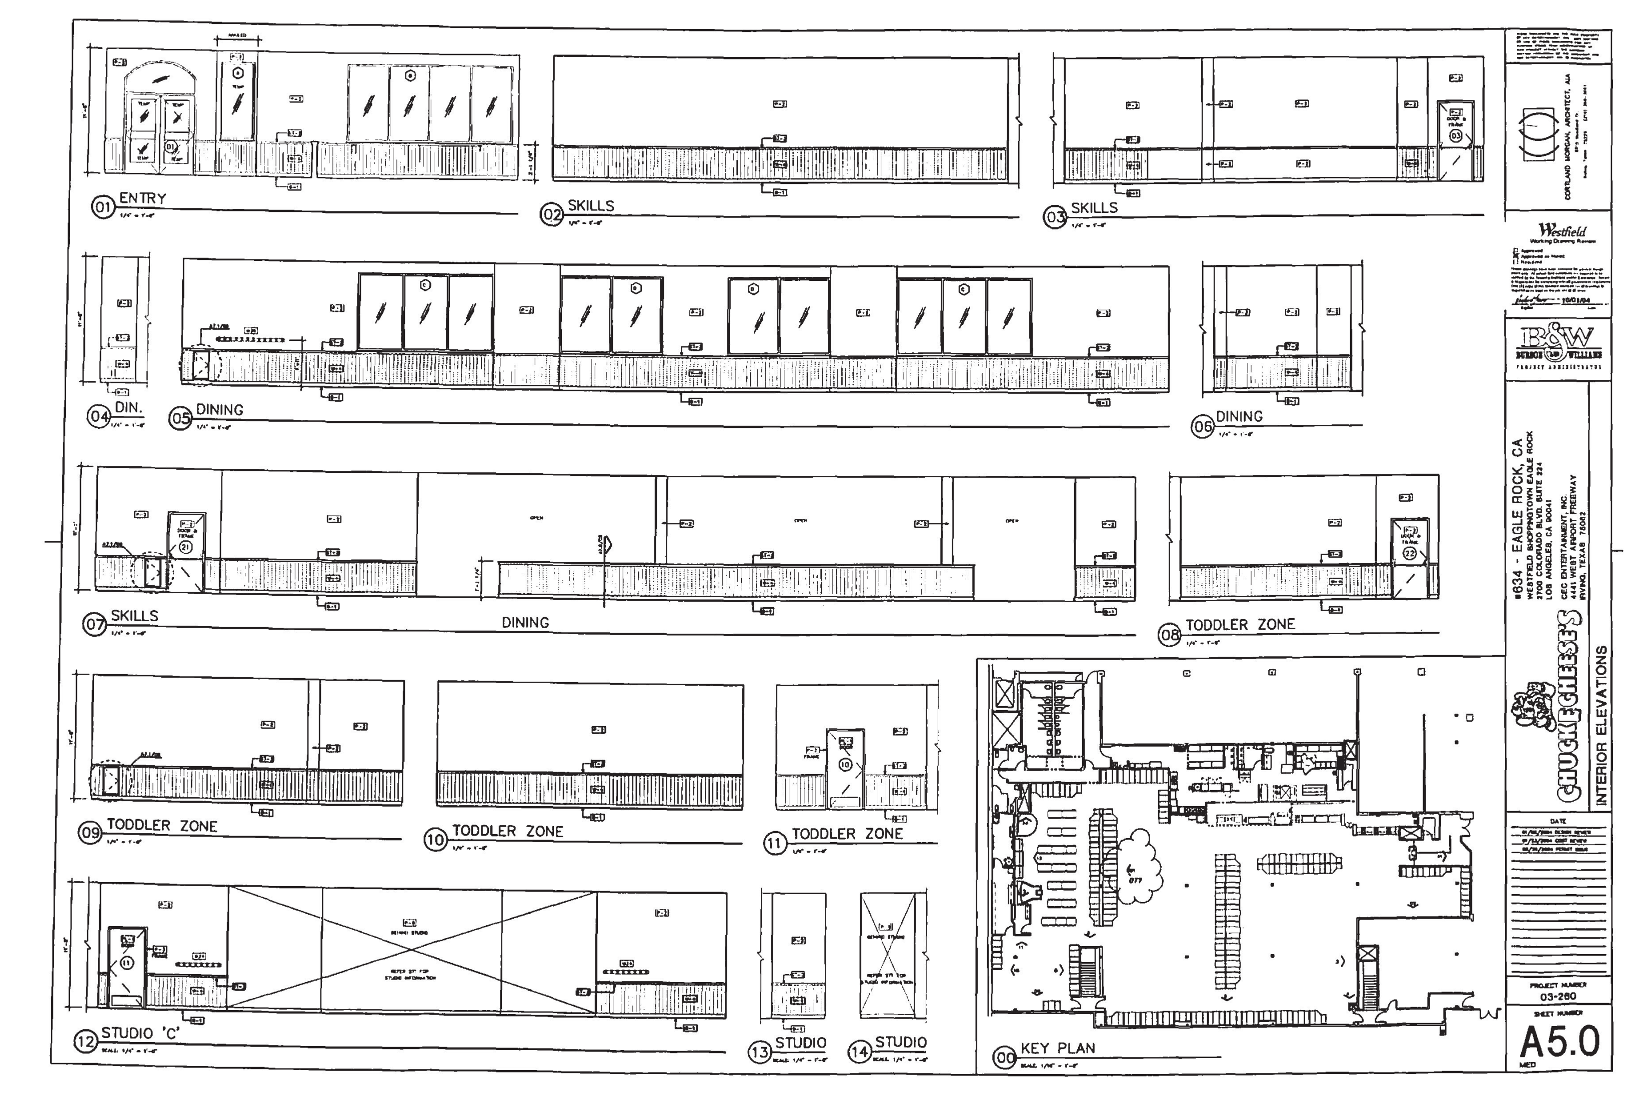
DEBTORS' EX. NO. 11
Page 93 of 130

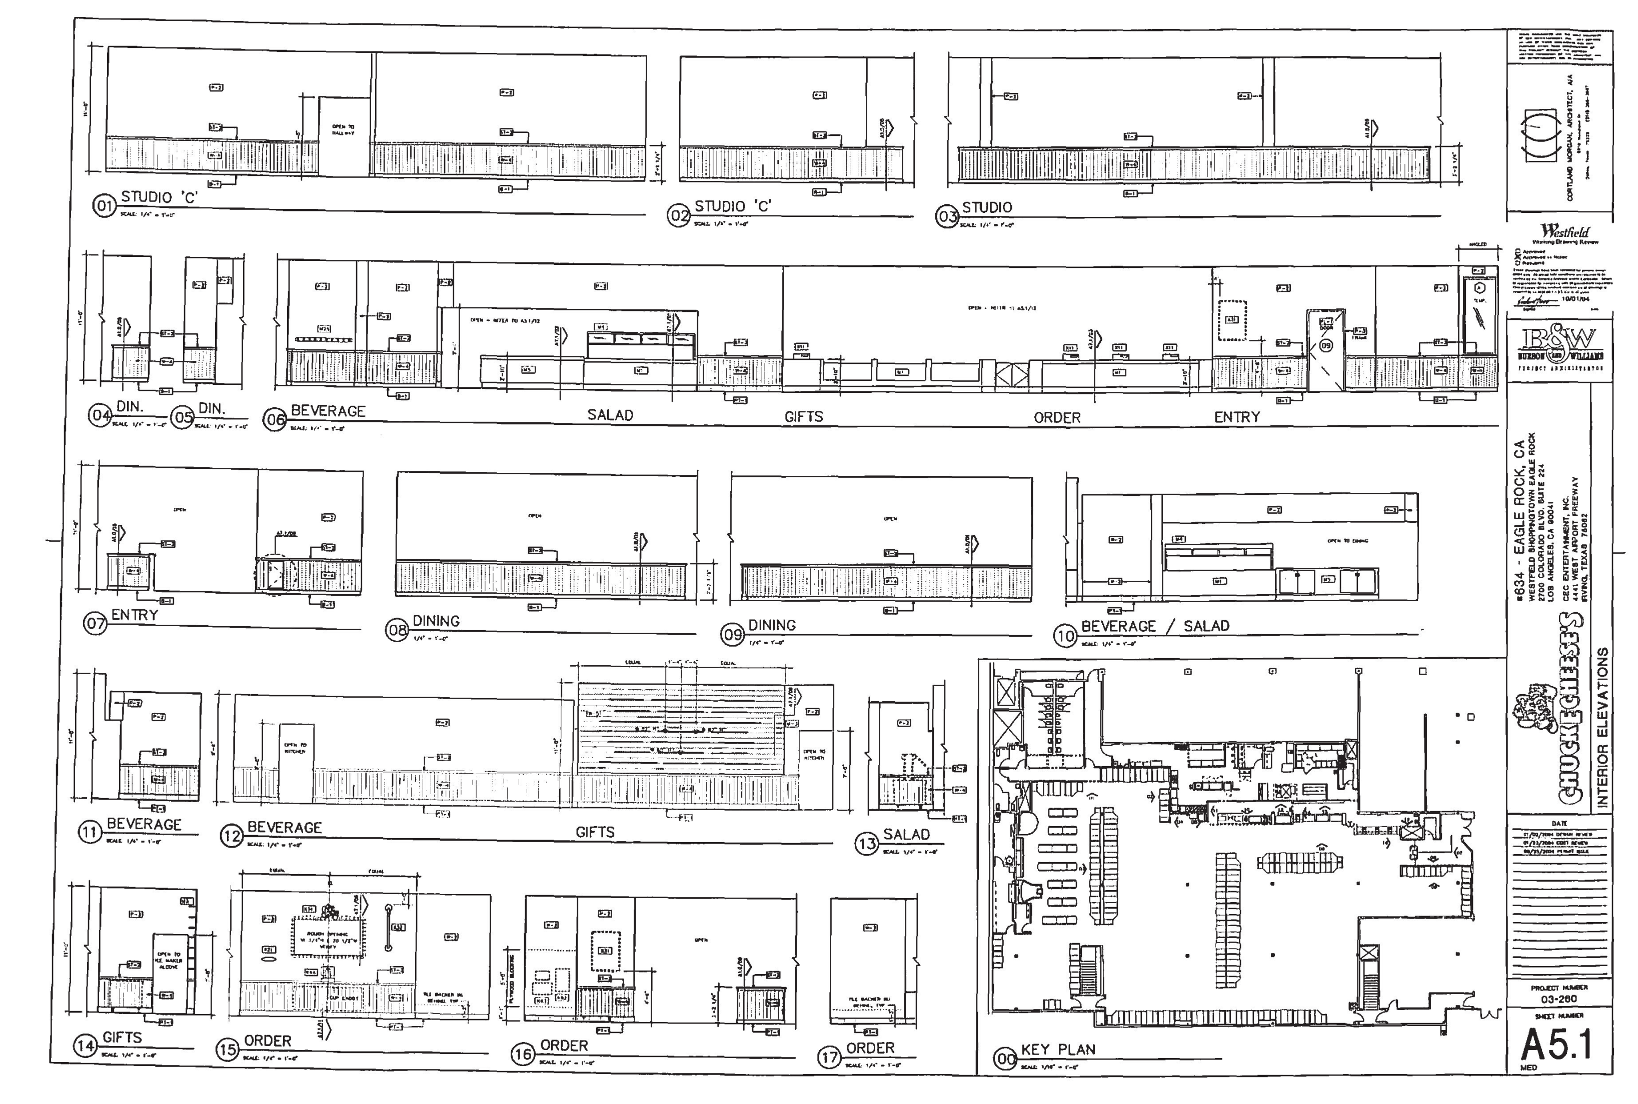


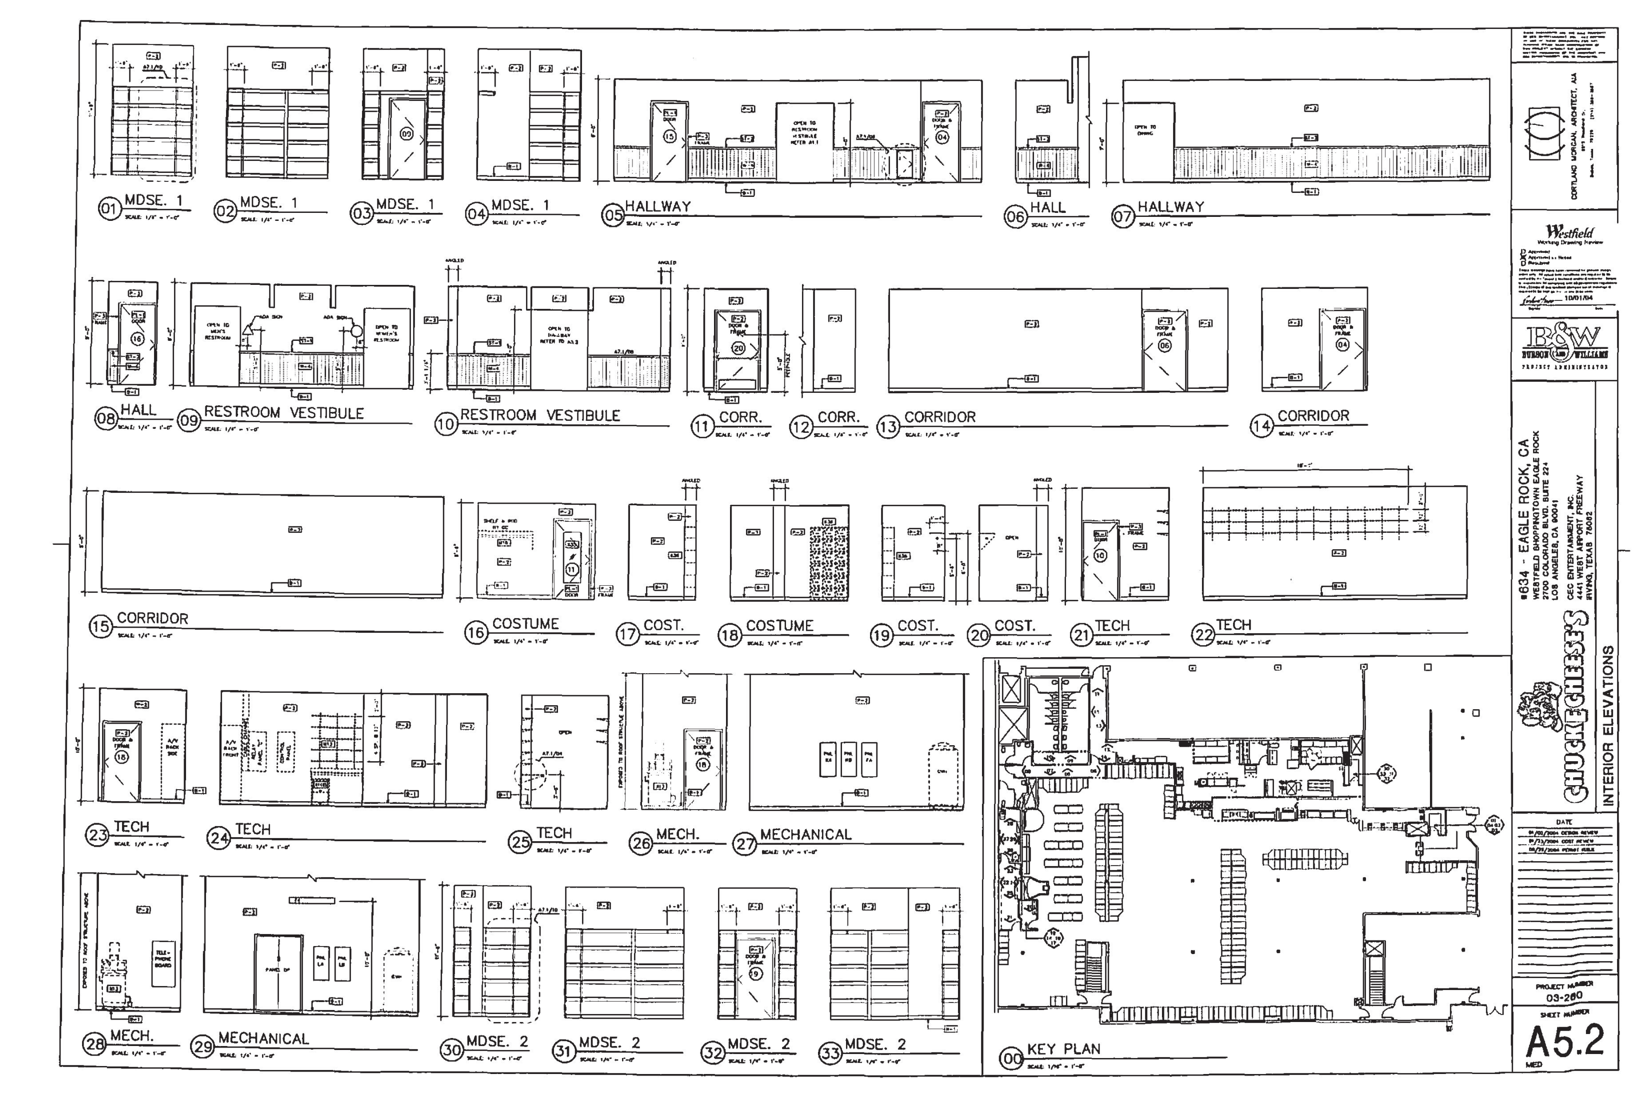
ROOF PLAN
MALL RTU #2
RTU1
RTU2
RTU3
RTU4
EF2
EF1
KEF1
SEF-1
VH-A
CAP
Verify clearance required with lower tenant equipment - 10' from EF2 to air intake, and for VHA to lower tenant exhaust.
MEMBRANE ROOF SYSTEM
GRANULAR SURFACE ROOF SYSTEM
TAR, FELT, & GRAVEL ROOF SYSTEM
ROOF EQUIPMENT SUPPORT
Review exact placement of all rooftop equipment with mall management prior to any roof cutting.
ROOF PENETRATION
Westfield
Working Drawing Review
Approved
Approved as Noted
Resubmit
#634 - EAGLE ROCK, CA
WESTFIELD SHOPPINGTOWN EAGLE ROCK
2700 COLORADO BLVD, SUITE 224
LOS ANGELES, CA 90041
CEC ENTERTAINMENT, INC.
4441 WEST AIRPORT FREEWAY
IRVING, TEXAS 75062
CHUCK E. CHEESE'S
ROOF PLAN
CORTLAND MORGAN, ARCHITECT, AIA
PROJECT NUMBER
03-260
SHEET NUMBER
A3.1

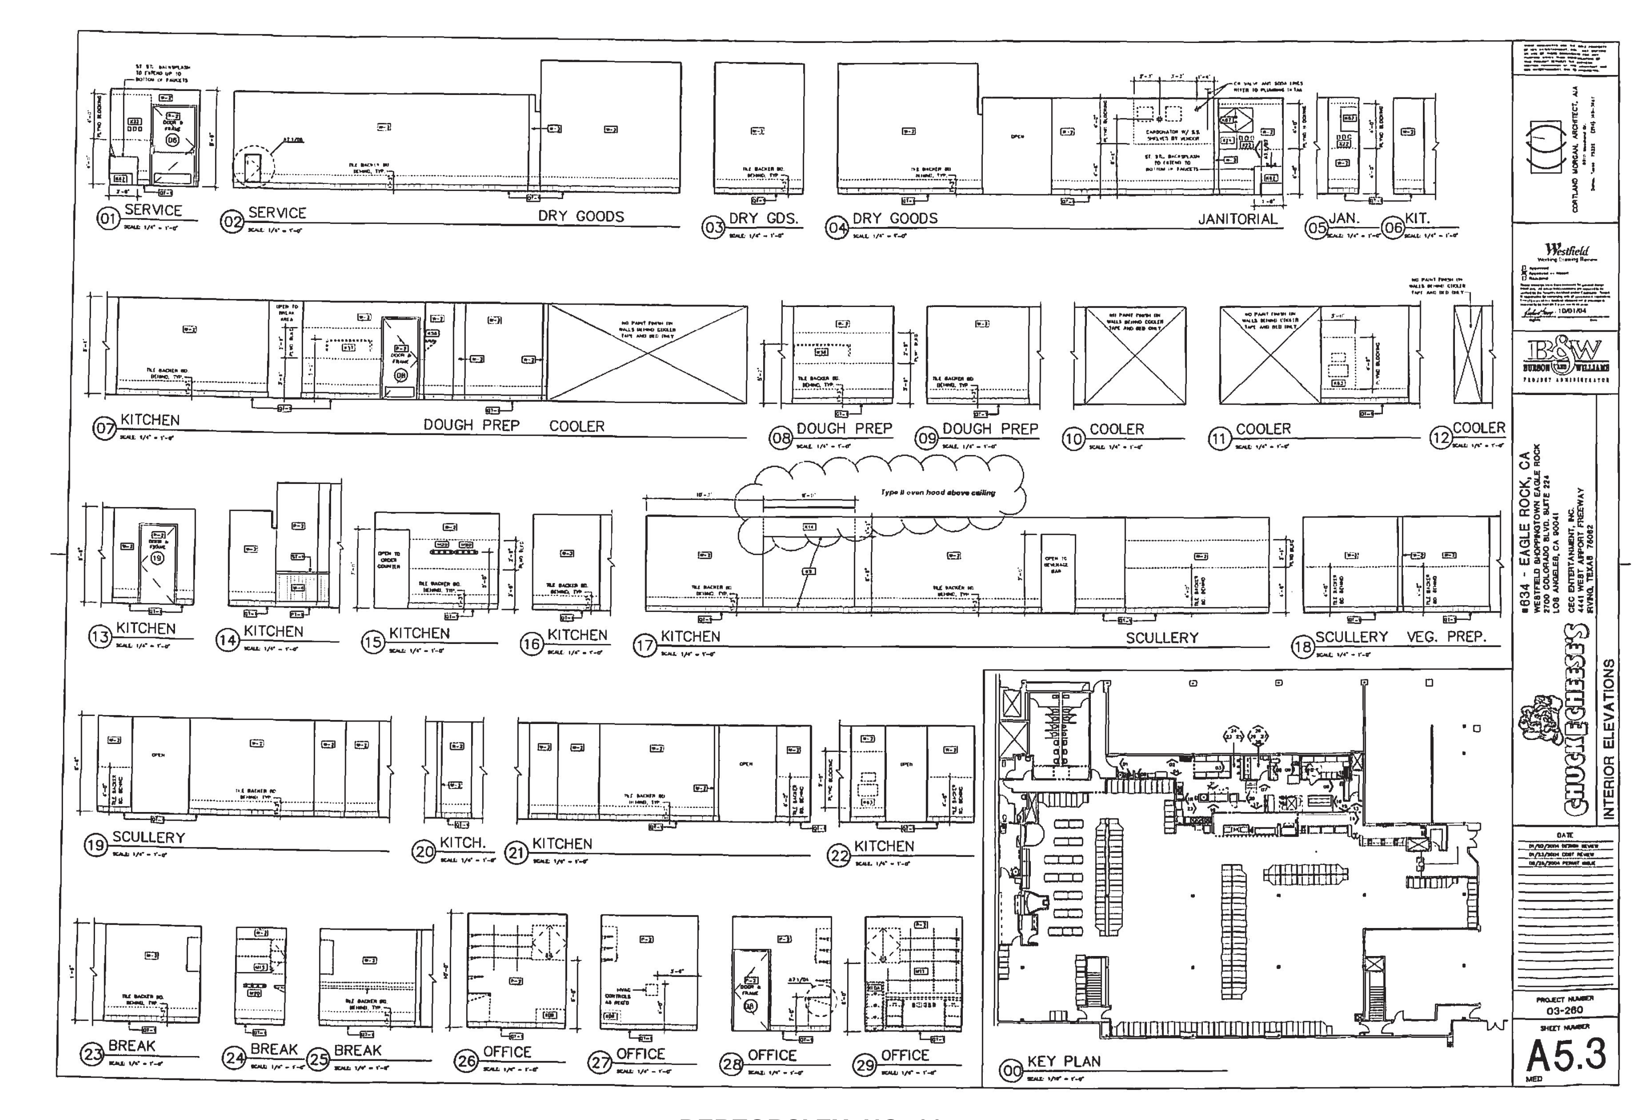


DEBTORS' EX. NO. 11
Page 95 of 130

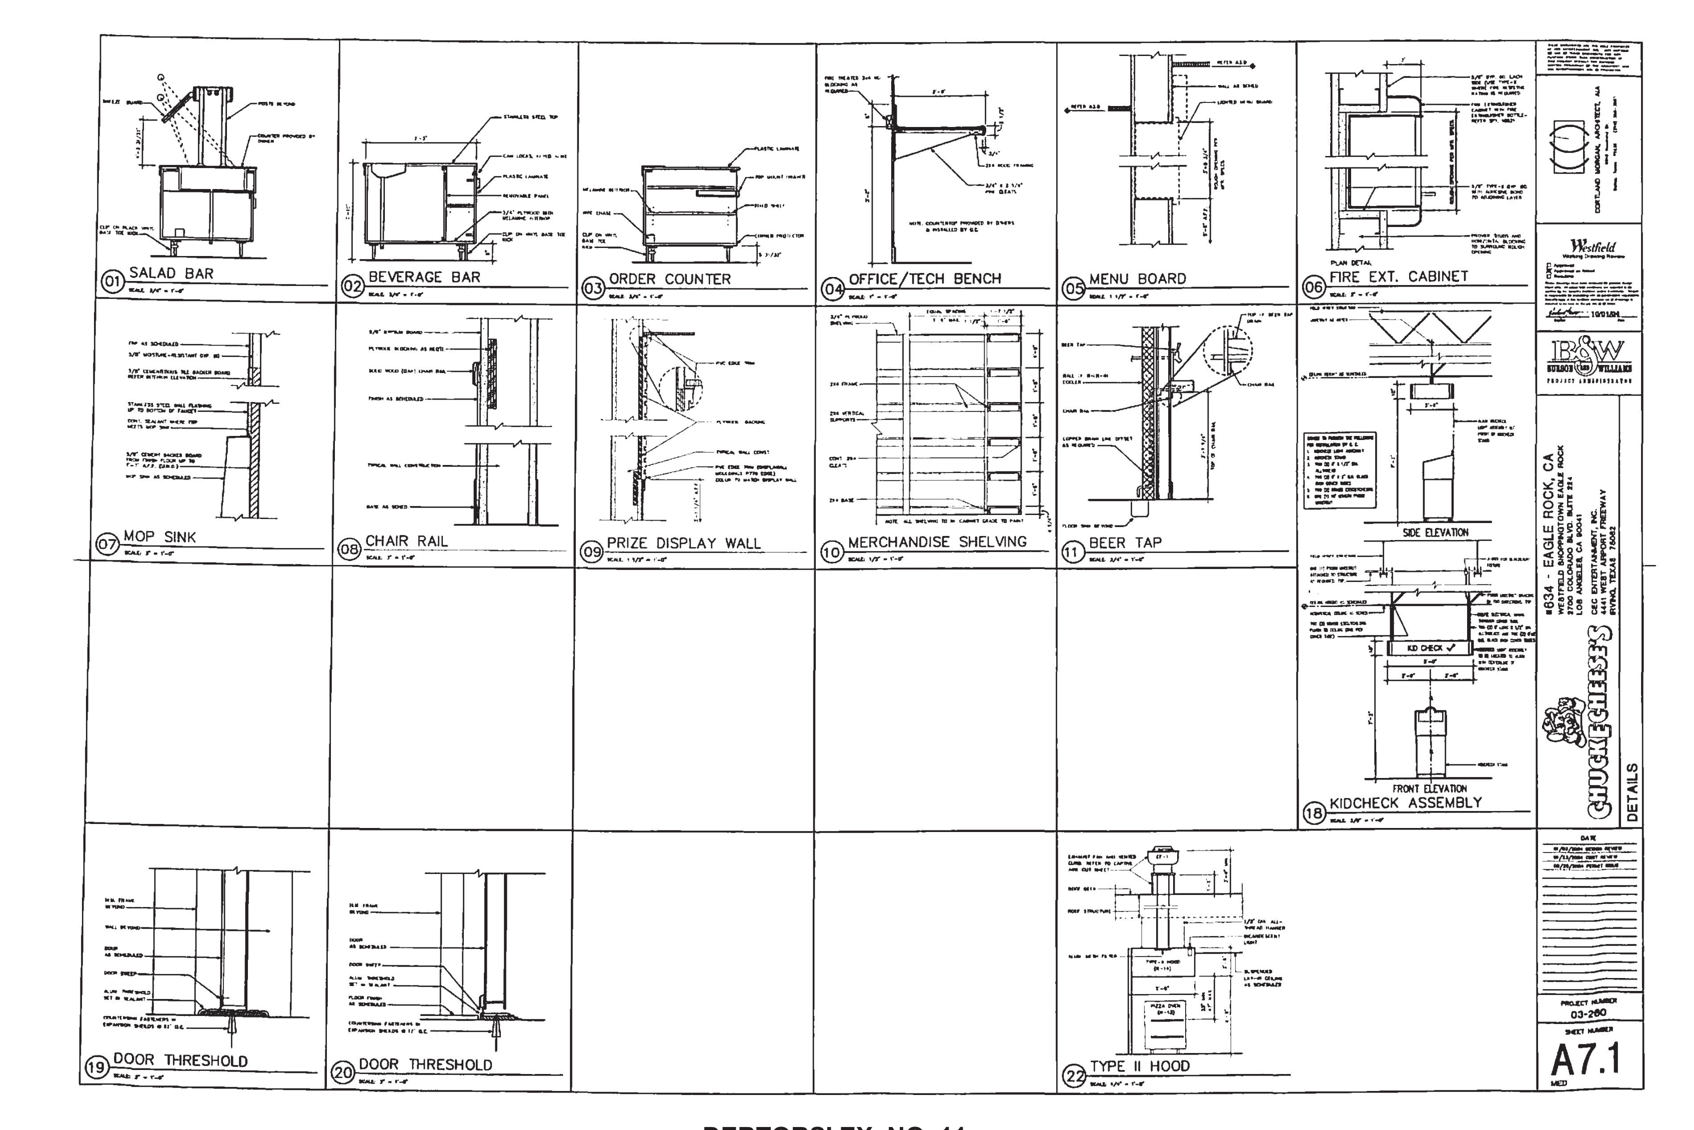

01 ENTRY
02 SKILLS
03 SKILLS
04 DIN.
05 DINING
06 DINING
07 SKILLS
DINING
08 TODDLER ZONE
09 TODDLER ZONE
10 TODDLER ZONE
11 TODDLER ZONE
12 STUDIO 'C'
13 STUDIO
14 STUDIO
00 KEY PLAN
CORTLAND MORGAN, ARCHITECT, AIA
Westfield
B&W
#634 - EAGLE ROCK, CA
WESTFIELD SHOPPINGTOWN EAGLE ROCK
2700 COLORADO BLVD. SUITE 224
LOS ANGELES, CA 90041
CEC ENTERTAINMENT, INC.
4441 WEST AIRPORT FREEWAY
IRVING, TEXAS 75062
CHUCK E. CHEESE'S
INTERIOR ELEVATIONS
DATE
PROJECT NUMBER
03-260
SHEET NUMBER
A5.0


01 STUDIO 'C'
02 STUDIO 'C'
03 STUDIO
04 DIN.
05 DIN.
06 BEVERAGE
SALAD
GIFTS
ORDER
ENTRY
07 ENTRY
08 DINING
09 DINING
10 BEVERAGE / SALAD
11 BEVERAGE
12 BEVERAGE
GIFTS
13 SALAD
14 GIFTS
15 ORDER
16 ORDER
17 ORDER
00 KEY PLAN
CORTLAND MORGAN, ARCHITECT, AIA
Westfield
B&W
#634 - EAGLE ROCK, CA
WESTFIELD SHOPPINGTOWN EAGLE ROCK
2700 COLORADO BLVD. SUITE 224
LOS ANGELES, CA 90041
CEC ENTERTAINMENT, INC.
4441 WEST AIRPORT FREEWAY
IRVING, TEXAS 75062
CHUCK E. CHEESE'S
INTERIOR ELEVATIONS
DATE
PROJECT NUMBER
03-260
SHEET NUMBER
A5.1


01 MDSE. 1
02 MDSE. 1
03 MDSE. 1
04 MDSE. 1
05 HALLWAY
06 HALL
07 HALLWAY
08 HALL
09 RESTROOM VESTIBULE
10 RESTROOM VESTIBULE
11 CORR.
12 CORR.
13 CORRIDOR
14 CORRIDOR
15 CORRIDOR
16 COSTUME
17 COST.
18 COSTUME
19 COST.
20 COST.
21 TECH
22 TECH
23 TECH
24 TECH
25 TECH
26 MECH.
27 MECHANICAL
28 MECH.
29 MECHANICAL
30 MDSE. 2
31 MDSE. 2
32 MDSE. 2
33 MDSE. 2
00 KEY PLAN
CORTLAND MORGAN, ARCHITECT, AIA
Westfield
B&W
BURSON AND WILLIAMS
#634 - EAGLE ROCK, CA
WESTFIELD SHOPPINGTOWN EAGLE ROCK
2700 COLORADO BLVD. SUITE 224
LOS ANGELES, CA 90041
CEC ENTERTAINMENT, INC.
4441 WEST AIRPORT FREEWAY
IRVING, TEXAS 75062
CHUCK E. CHEESE'S
INTERIOR ELEVATIONS
DATE
PROJECT NUMBER
03-260
SHEET NUMBER
A5.2



DEBTORS' EX. NO. 11
Page 99 of 130


01 SALAD BAR
02 BEVERAGE BAR
03 ORDER COUNTER
04 OFFICE/TECH BENCH
05 MENU BOARD
06 FIRE EXT. CABINET
07 MOP SINK
08 CHAIR RAIL
09 PRIZE DISPLAY WALL
10 MERCHANDISE SHELVING
11 BEER TAP
SIDE ELEVATION
KID CHECK
FRONT ELEVATION
18 KIDCHECK ASSEMBLY
19 DOOR THRESHOLD
20 DOOR THRESHOLD
22 TYPE II HOOD
CORTLAND MORGAN, ARCHITECT, AIA
Westfield
B&W
#634 - EAGLE ROCK, CA
WESTFIELD SHOPPINGTOWN EAGLE ROCK
2700 COLORADO BLVD. SUITE 224
LOS ANGELES, CA 90041
CEC ENTERTAINMENT, INC.
4441 WEST AIRPORT FREEWAY
IRVING, TEXAS 75062
CHUCK E. CHEESE'S
DETAILS
PROJECT NUMBER
03-260
SHEET NUMBER
A7.1

HARDWARE SCHEDULE

HARDWARE SET NO. 1 - DOUBLE FRONT ENTRANCE DOORS

HARDWARE SET NO. 2 - DOUBLE ENTRY/LOBBY DOORS

HARDWARE SET NO. 3 - TRAFFIC DOORS

HARDWARE SET NO. 4 - EXTERIOR KITCHEN SERVICE DOORS

HARDWARE SET NO. 6 - EXIT DOOR

HARDWARE SET NO. 6 - TOILET ROOMS

HARDWARE SET NO. 7 - KITCHEN DOORS

HARDWARE SET NO. 8 - INTERIOR MECHANICAL DOOR

HARDWARE SET NO. 9 - CONTROL/OFFICE

HARDWARE SET NO. 10 - MERCHANDISE/TECH DOOR

HARDWARE SET NO. 11 - SINGLE TOILET DOOR

HARDWARE SET NO. 12 - STOREFRONT EXIT DOOR

HARDWARE SET NO. 13 - EXTERIOR UTILITY ROOM DOOR

HARDWARE SET NO. 14 - COSTUME ROOM

COMPLY WITH SECTIONS 08340, 01600 AND 08710 AS SET FORTH ON SHEET SP1.

KEY ALL LOCKS ON DAY OF TURNOVER. THE DOORS SHOULD BE KEYED AS FOLLOWED:

COPIES OF EACH KEY:

FINISH KEY

REFER TO SPECIFICATIONS ON SHEET SP-1

03300 CONCRETE

04220 MASONRY

05720 ORNAMENTAL METAL

06410 PLASTIC LAMINATE (PLAM)

09260 EXTERIOR INSULATION & FINISH SYSTEM (E.I.F.S.)

09260 GYPSUM DRYWALL (GWB)

09310 PORCELAIN FLOOR/WALL TILE

09311 CERAMIC WALL TILE

09330 QUARRY TILE

09510 ACOUSTICAL LAY-IN CEILINGS

09678 RESILIENT BASE

09687 CARPET

09900 PAINT/STAINS

P-1 HOLLYBERRY RED

P-2 LIGHTMOVES

P-3 WINDSOR GRAY

P-4 OYSTER SHELL

P-5 MORNING HAZE

P-6 PANCAKE

P-7 HAZE

P-8 STONES THROW

P-9 FLAT BLACK

P-10 HARVESTER

ST1 INTERIOR OAK

ST2 INTERIOR OAK

ST3 INTERIOR MAPLE

09971 FIBERGLASS REINFORCED PANELS (FRP)

09972 MARLITE WALL PANELS

FLAME SPREADS

MATERIAL	REFERENCE	FLAME SPREAD	
[illegible]	[illegible]	[illegible]	[illegible]

DOOR SCHEDULE

DOOR NO.	DOOR SIZE	DOOR TYPE MATERIAL	DOOR TYPE FINISH	FRAME TYPE MATERIAL	FRAME TYPE FINISH	HARD WARE SET #	LOCATION	DETAILS HEAD	DETAILS JAMB	THRESH	NOTES
[illegible]	[illegible]	[illegible]	[illegible]	[illegible]	[illegible]	[illegible]	[illegible]	[illegible]	[illegible]	[illegible]	[illegible]

DOOR TYPES

TYPE "A" ALUMINUM ENTRANCE

TYPE "B" SOLID CORE WOOD

TYPE "C" HOLLOW METAL

TYPE "D" HOLLOW METAL

TYPE "E"

TYPE "F" ALUMINUM STOREFRONT EXIT

TYPE "G" ALUMINUM ENTRANCE

CORTLAND MORGAN, ARCHITECT, AIA

Westfield Working Drawing Review

B&W BURBON WILLIAMS PROJECT ADMINISTRATORS

#834 - EAGLE ROCK, CA
WESTFIELD SHOPPINGTOWN EAGLE ROCK
2700 COLORADO BLVD. SUITE 224
LOS ANGELES, CA 90041

CEC ENTERTAINMENT, INC.
4441 WEST AIRPORT FREEWAY
IRVING, TEXAS 75062

CHUCK E. CHEESE'S

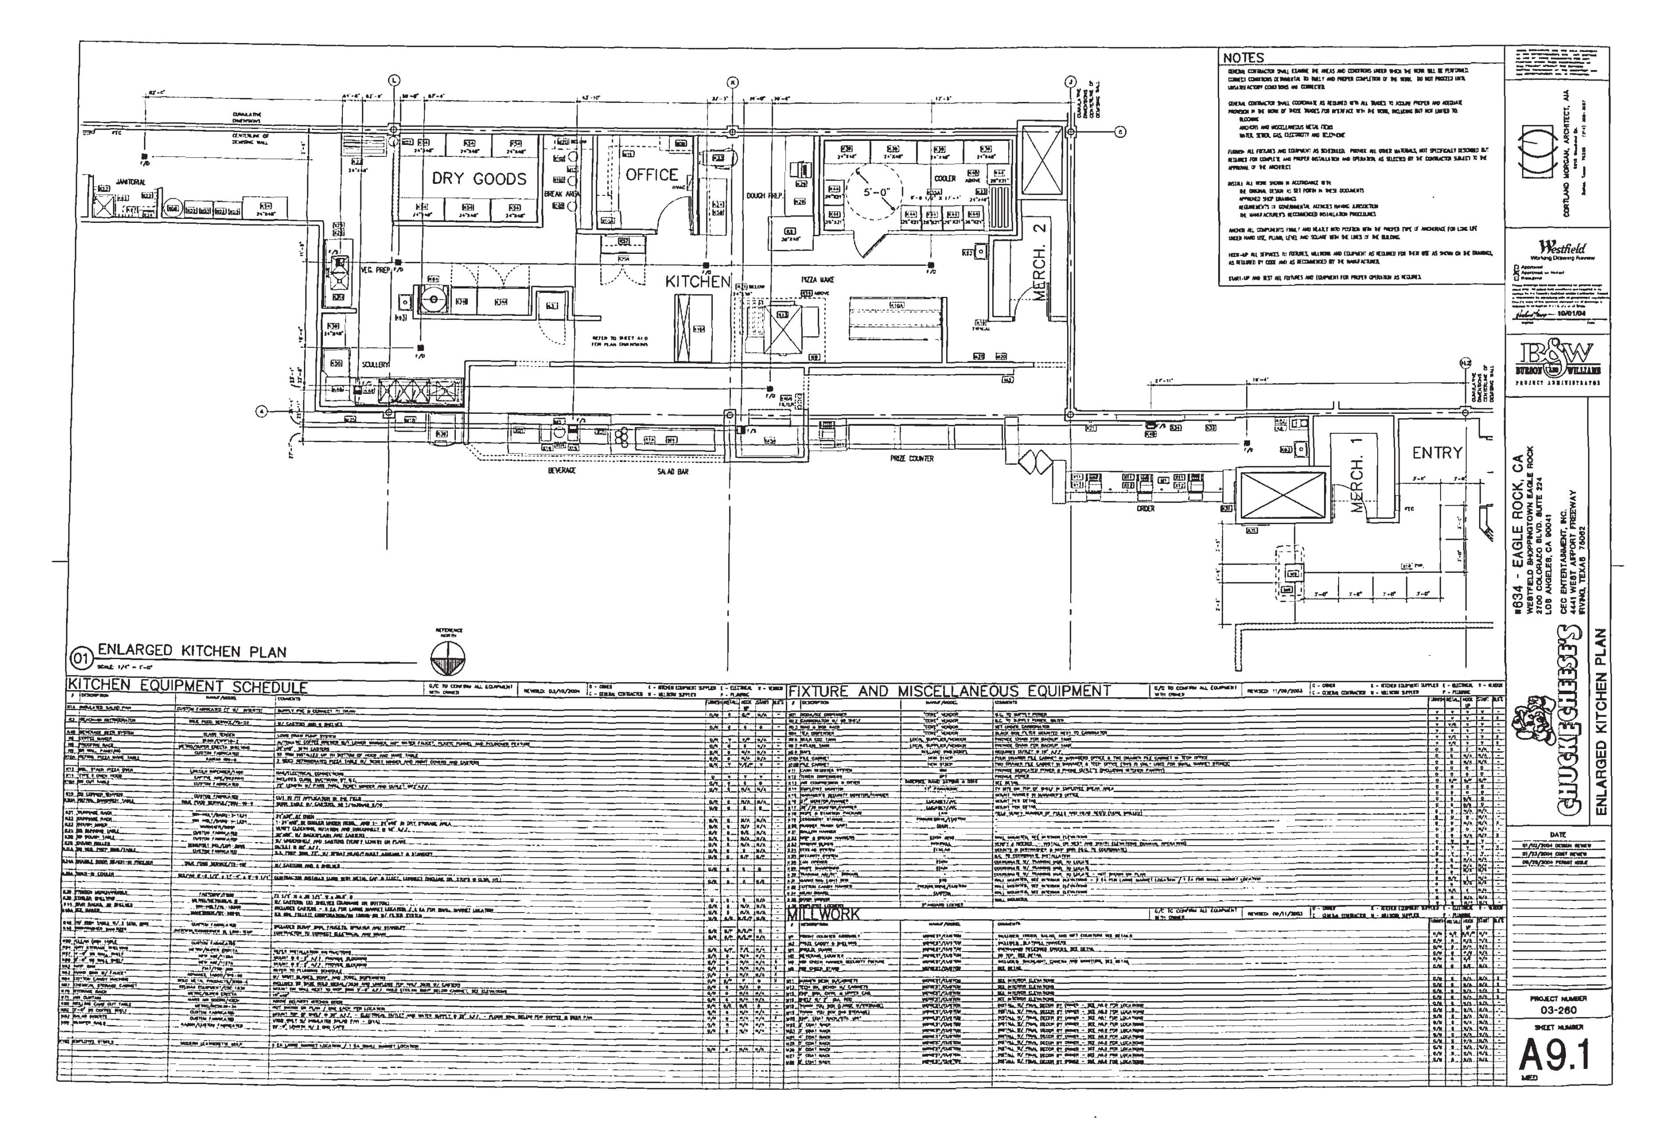
SCHEDULES

DATE

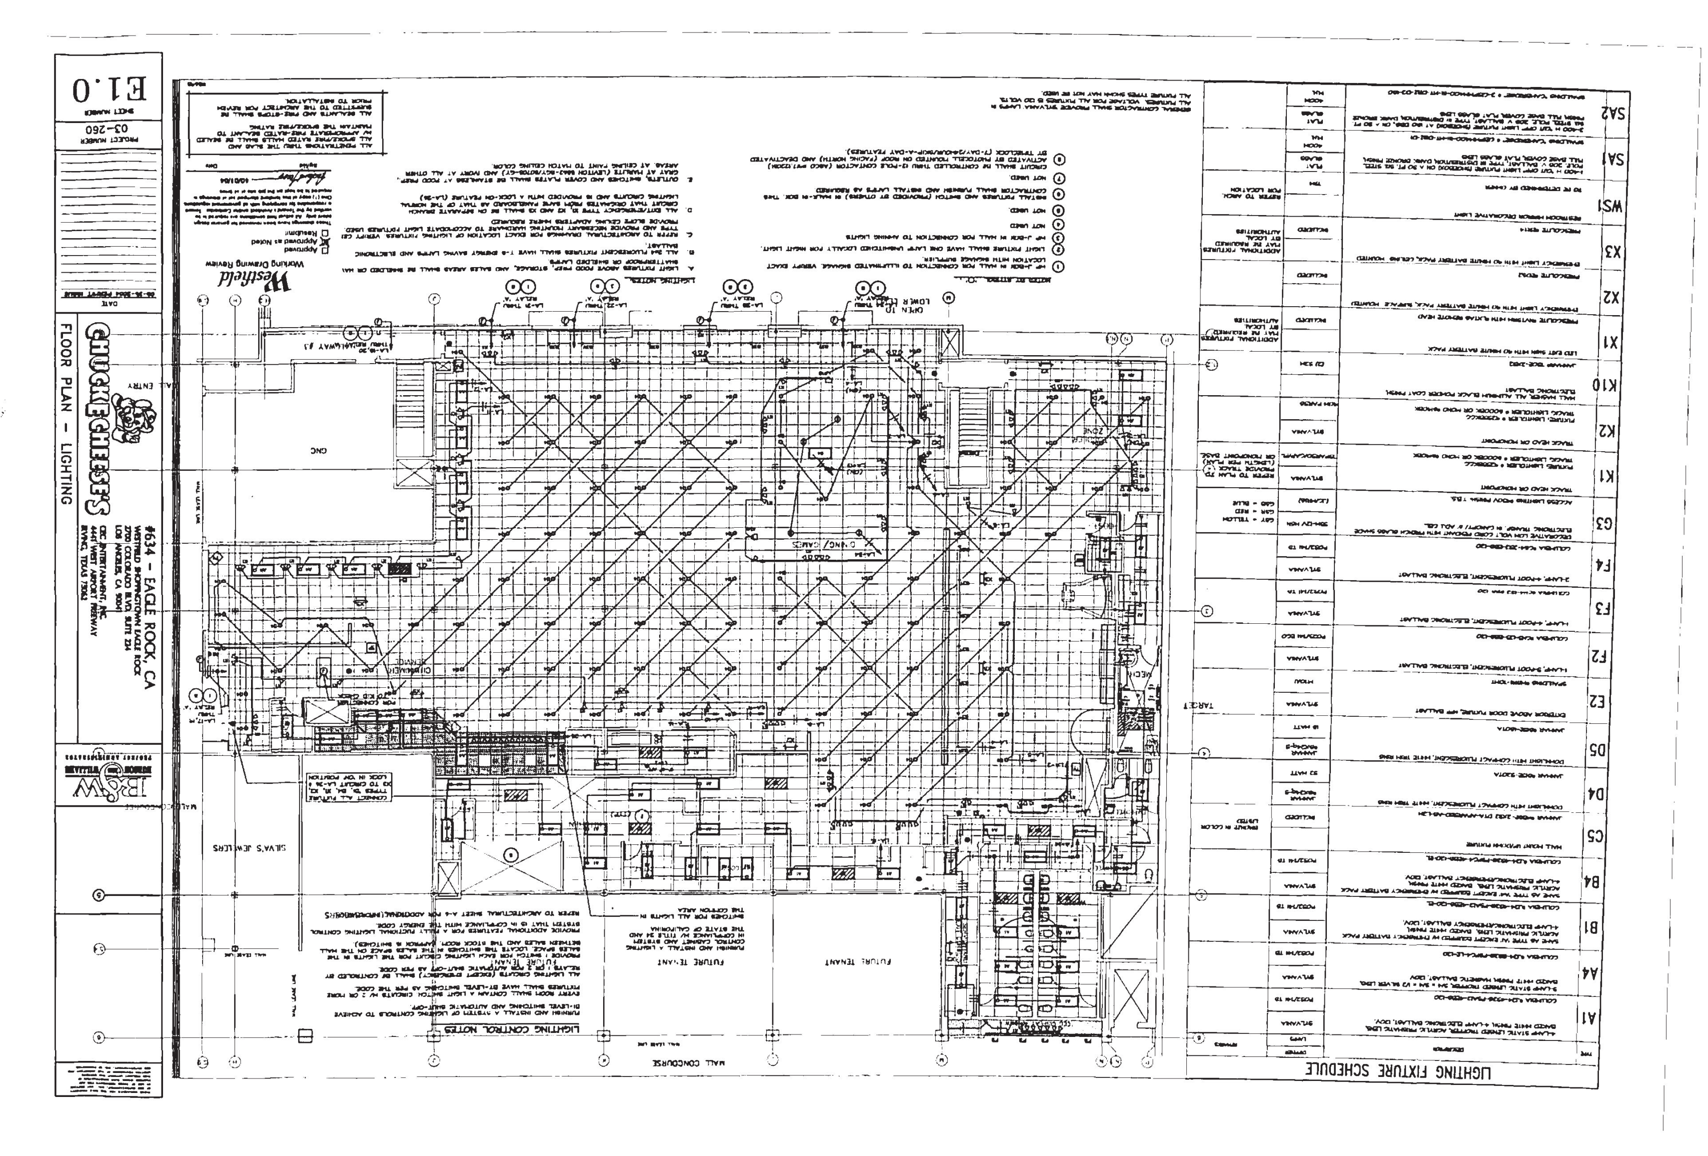
PROJECT NUMBER 03-260


MED



DEBTORS' EX. NO. 11
Page 102 of 130


LIGHTING FIXTURE SCHEDULE
LIGHTING CONTROL NOTES
LIGHTING NOTES
MALL CONCOURSE
FUTURE TENANT
SILVA'S JEWELERS
Westfield
Working Drawing Review
CHUCK E. CHEESE'S
#634 - EAGLE ROCK, CA
WESTFIELD SHOPPINGTOWN EAGLE ROCK
2700 COLORADO BLVD, SUITE 234
LOS ANGELES, CA 90041
CEC ENTERTAINMENT, INC.
4441 WEST AIRPORT FREEWAY
IRVING, TEXAS 75062
FLOOR PLAN - LIGHTING
03-260
E1.0

SPECIFICATIONS

DIVISION 1 - GENERAL CONDITIONS

01010 Summary of Work

01210 Preconstruction Meeting

01310 Construction Schedules

01340 Submittals

01410 Testing Laboratory Services

01500 Temporary Facilities and Controls

01630 Substitutions and Product Options

01700 Project Closeout

01710 Cleaning

01720 Project Record Documents

01730 Operation, Maintenance & Warranty Data

01740 Accessibility Inspection & Certification

DIVISION 2 - SITE WORK

02070 Selective Demolition

02575 Pavement Repair

DIVISION 3 - CONCRETE

03200 Concrete Reinforcement

03300 Cast-in-Place Concrete

DIVISION 4 - MASONRY

04220 Concrete Unit Masonry

DIVISION 5 - METALS

05100 Structural Metal Framing

05400 Cold-Formed Metal Framing

05500 Metal Fabrications

05720 Ornamental Metal

LEASE AGREEMENT SUPERCEDES NOTES RELATING TO FEES, PERMITS, UTILITIES

DIVISION 6 - WOOD AND PLASTICS

06100 Rough Carpentry

06200 Finish Carpentry

06410 Millwork

DIVISION 7 - THERMAL & MOISTURE

07210 Building Insulation

07511 Membrane Roofing Repair

07600 Flashing and Sheet Metal

07700 Roof Specialties

07920 Sealants and Caulking

DIVISION 8 - DOORS AND WINDOWS

08100 Metal Doors and Frames

08211 Flush Wood Doors

08411 Aluminum Storefronts

08412 Aluminum Entrance Doors

08710 Finish Hardware

08800 Glazing

DIVISION 9 - FINISHES

09201 Exterior Insulation & Finish System

09260 Gypsum Wall Board System

09310 Porcelain Floor Tile

09311 Ceramic Wall Tile

09330 Quarry Tile

09510 Acoustical Ceilings

09660 Resilient Flooring

09678 Resilient Base

09687 Carpet

09900 Painting

09971 Fiberglass Wall Panels

09972 Marlite Wall Panels

DIVISION 10 - SPECIALTIES

10162 Toilet Partitions

10260 Wall Corner Guards

10400 Signage

10521 Portable Fire Extinguishers

10701 Exterior Backlit Awnings

10800 Toilet Room Accessories

DIVISION 11 - EQUIPMENT

11400 Fixtures and Equipment

DIVISION 12 - FURNISHINGS

12100 Decor

12520 Window Shades

12600 Furniture

DIVISION 13 - DIVISION 14

DIVISION 15 - MECHANICAL

15331 Fire Sprinkler System Modifications

15401 Domestic Water

15402 Sanitary Sewer

15403 Grease Trap

15425 Gas System

15450 Plumbing Fixtures

15731 Compressed Air System

15805 Air Distribution

15903 Controls

15950 System Balancing

DIVISION 16 - ELECTRICAL

16101 Modify Existing Service

16400 Distribution and Lighting Panelboards

16500 Lighting

16721 Fire Alarm System

16725 Security Access System

16741 Telephone System

16742 Point of Sale System

Westfield
Working Drawing Review
Approved
Approved as Noted
Resubmit

CORTLAND MORGAN, ARCHITECT, AIA

B&W BURSON WILLIAMS

#834 - EAGLE ROCK, CA
WESTFIELD SHOPPINGTOWN EAGLE ROCK
2700 COLORADO BLVD. SUITE 224
LOS ANGELES, CA 90041

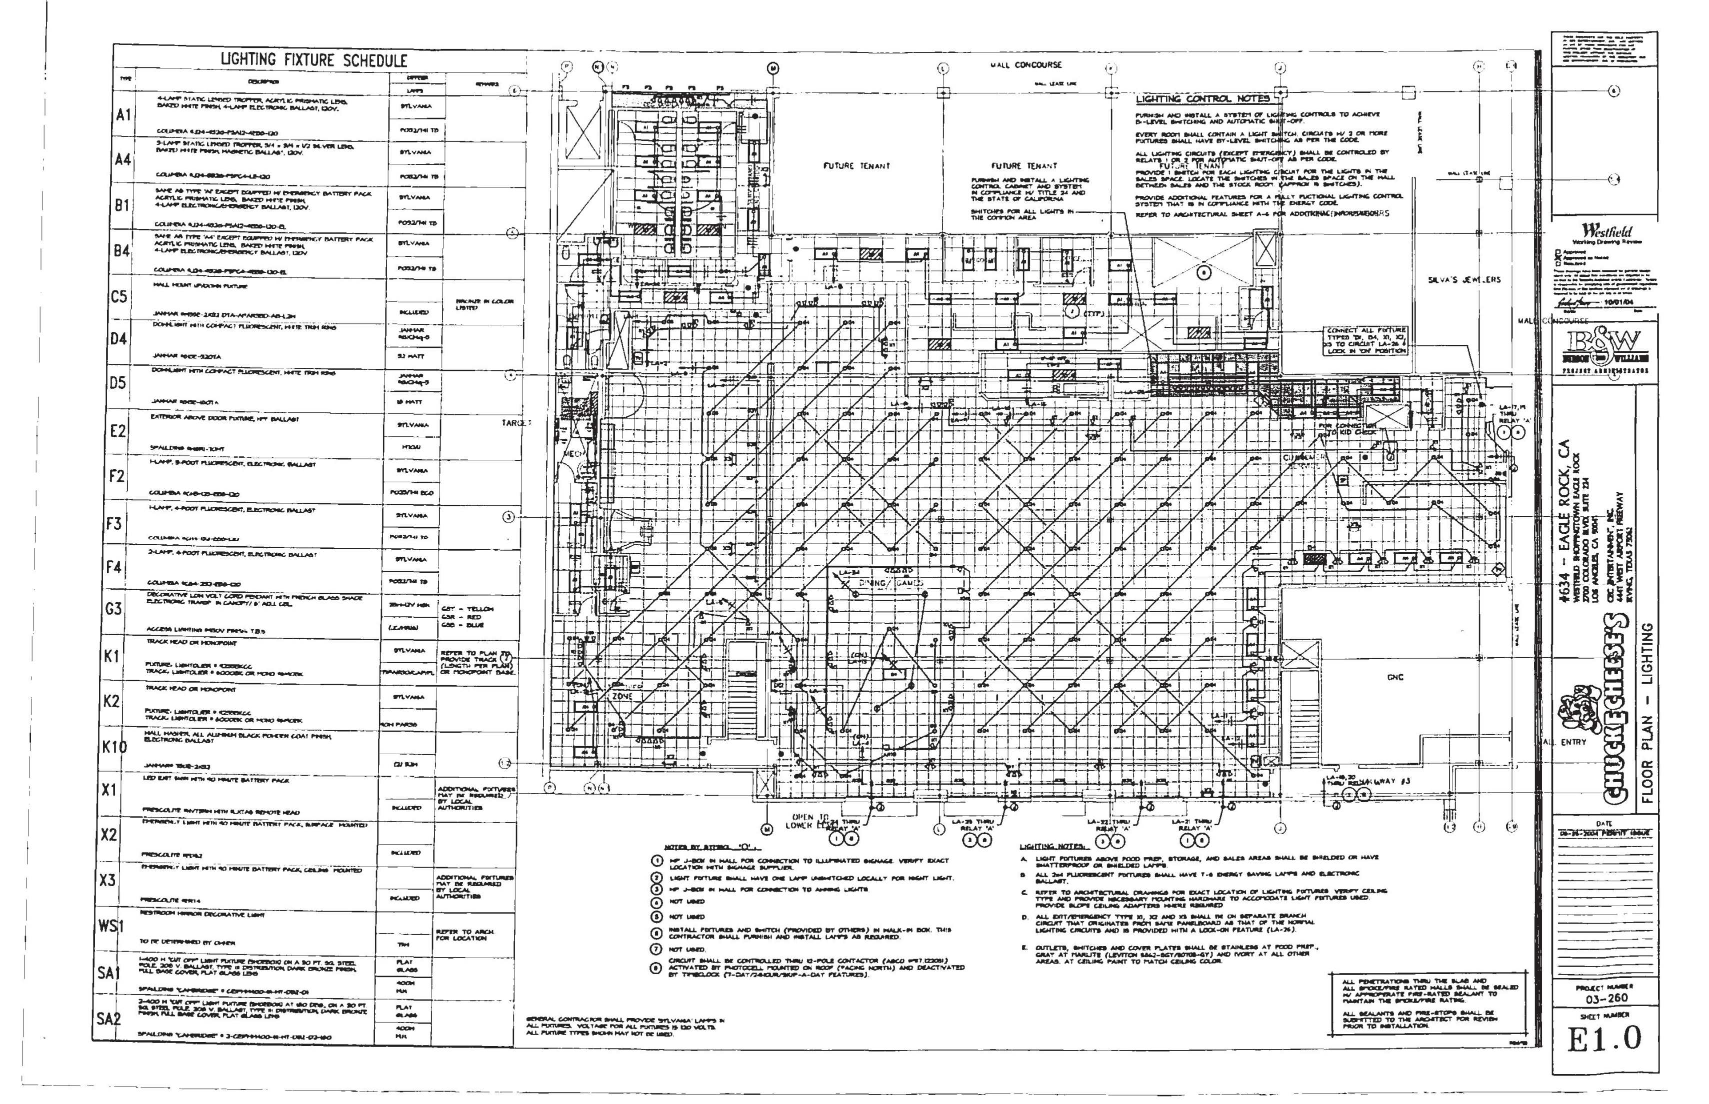
CEC ENTERTAINMENT, INC.
4441 WEST AIRPORT FREEWAY
IRVING, TEXAS 75062

CHUCK E. CHEESE'S

SPECIFICATIONS

PROJECT NUMBER 03-260

SHEET NUMBER SP1


LIGHTING FIXTURE SCHEDULE
A1
A4
B1
B4
C5
D4
D5
E2
F2
F3
F4
G3
K1
K2
K10
X1
X2
X3
WS1
SA1
SA2
GAT - YELLOW
GSR - RED
GBB - BLUE
MALL CONCOURSE
FUTURE TENANT
FUTURE TENANT
LIGHTING CONTROL NOTES
FURNISH AND INSTALL A SYSTEM OF LIGHTING CONTROLS TO ACHIEVE BI-LEVEL SWITCHING AND AUTOMATIC SHUT-OFF.
EVERY ROOM SHALL CONTAIN A LIGHT SWITCH. CIRCUITS W/ 2 OR MORE FIXTURES SHALL HAVE BY-LEVEL SWITCHING AS PER THE CODE.
ALL LIGHTING CIRCUITS (EXCEPT EMERGENCY) SHALL BE CONTROLED BY RELAYS 1 OR 2 FOR AUTOMATIC SHUT-OFF AS PER CODE.
PROVIDE 1 SWITCH FOR EACH LIGHTING CIRCUIT FOR THE LIGHTS IN THE SALES SPACE. LOCATE THE SWITCHES IN THE SALES SPACE ON THE WALL BETWEEN SALES AND THE STOCK ROOM. (APPROX 8 SWITCHES).
PROVIDE ADDITIONAL FEATURES FOR A FULLY FUCTIONAL LIGHTING CONTROL SYSTEM THAT IS IN COMPLIANCE WITH THE ENERGY CODE.
REFER TO ARCHITECTURAL SHEET A-6 FOR ADDITIONAL INFORMATION.
SILVA'S JEWELERS
MALL CONCOURSE
DINING/GAMES
ZONE
GNC
MALL ENTRY
OPEN TO LOWER LEVEL
LA-24 THRU RELAY 'A'
LA-23 THRU RELAY 'A'
LA-22 THRU RELAY 'A'
LA-21 THRU RELAY 'A'
HALLWAY #3
NOTES BY SYMBOL 'O'.
1 WP J-BOX IN WALL FOR CONNECTION TO ILLUMINATED SIGNAGE. VERIFY EXACT LOCATION WITH SIGNAGE SUPPLIER.
2 LIGHT FIXTURE SHALL HAVE ONE LAMP UNSWITCHED LOCALLY FOR NIGHT LIGHT.
3 WP J-BOX IN WALL FOR CONNECTION TO AWNING LIGHTS.
4 NOT USED
5 NOT USED
6 INSTALL FIXTURES AND SWITCH (PROVIDED BY OTHERS) IN WALK-IN BOX. THIS CONTRACTOR SHALL FURNISH AND INSTALL LAMPS AS REQUIRED.
7 NOT USED.
8 CIRCUIT SHALL BE CONTROLLED THRU 12-POLE CONTACTOR (ASCO #917,12208) ACTIVATED BY PHOTOCELL MOUNTED ON ROOF (FACING NORTH) AND DEACTIVATED BY TIMECLOCK (7-DAY/24HOUR/SKIP-A-DAY FEATURES).
LIGHTING NOTES.
A. LIGHT FIXTURES ABOVE FOOD PREP, STORAGE, AND SALES AREAS SHALL BE SHIELDED OR HAVE SHATTERPROOF OR SHIELDED LAMPS.
B. ALL 2x4 FLUORESCENT FIXTURES SHALL HAVE T-8 ENERGY SAVING LAMPS AND ELECTRONIC BALLAST.
C. REFER TO ARCHITECTURAL DRAWINGS FOR EXACT LOCATION OF LIGHTING FIXTURES. VERIFY CEILING TYPE AND PROVIDE NECESSARY MOUNTING HARDWARE TO ACCOMODATE LIGHT FIXTURES USED. PROVIDE SLOPE CEILING ADAPTERS WHERE REQUIRED.
D. ALL EXIT/EMERGENCY TYPE X1, X2 AND X3 SHALL BE ON SEPARATE BRANCH CIRCUIT THAT ORIGINATES FROM SAME PANELBOARD AS THAT OF THE NORMAL LIGHTING CIRCUITS AND IS PROVIDED WITH A LOCK-ON FEATURE (LA-26).
E. OUTLETS, SWITCHES AND COVER PLATES SHALL BE STAINLESS AT FOOD PREP., GRAY AT MARLITE (LEVITON 5262-SGY/80708-GY) AND IVORY AT ALL OTHER AREAS. AT CEILING PAINT TO MATCH CEILING COLOR.
Westfield
B&W
#634 - EAGLE ROCK, CA
CHUCK E. CHEESE'S
FLOOR PLAN - LIGHTING
03-260
E1.0

01 FLOOR PLAN – POWER

02 ENLARGED MECHANICAL/ TECH/COSTUME PLAN

GENERAL NOTES:

NOTES BY SYMBOL 'O':

ELECTRICAL
SYMBOLS & ABBREVIATIONS

REFERENCE SHEET A2.0 FOR DIMENSION LAYOUT OF GAMES FLOOR OUTLETS

KITCHEN

CUSTOMER SERVICE

DINING/ GAMES

HALLWAY #3

OPEN TO LOWER LEVEL

MECH.

TECH

COST.

WOMEN

MEN

Co-ordinate access to lower tenant and installation of generator with mall management

Westfield

#634 – EAGLE ROCK, CA
WESTFIELD SHOPPINGTOWN EAGLE ROCK
2700 COLORADO BLVD. SUITE 224
LOS ANGELES, CA 90041

CEC ENTERTAINMENT, INC.
4441 WEST AIRPORT FREEWAY
IRVING, TEXAS 75062

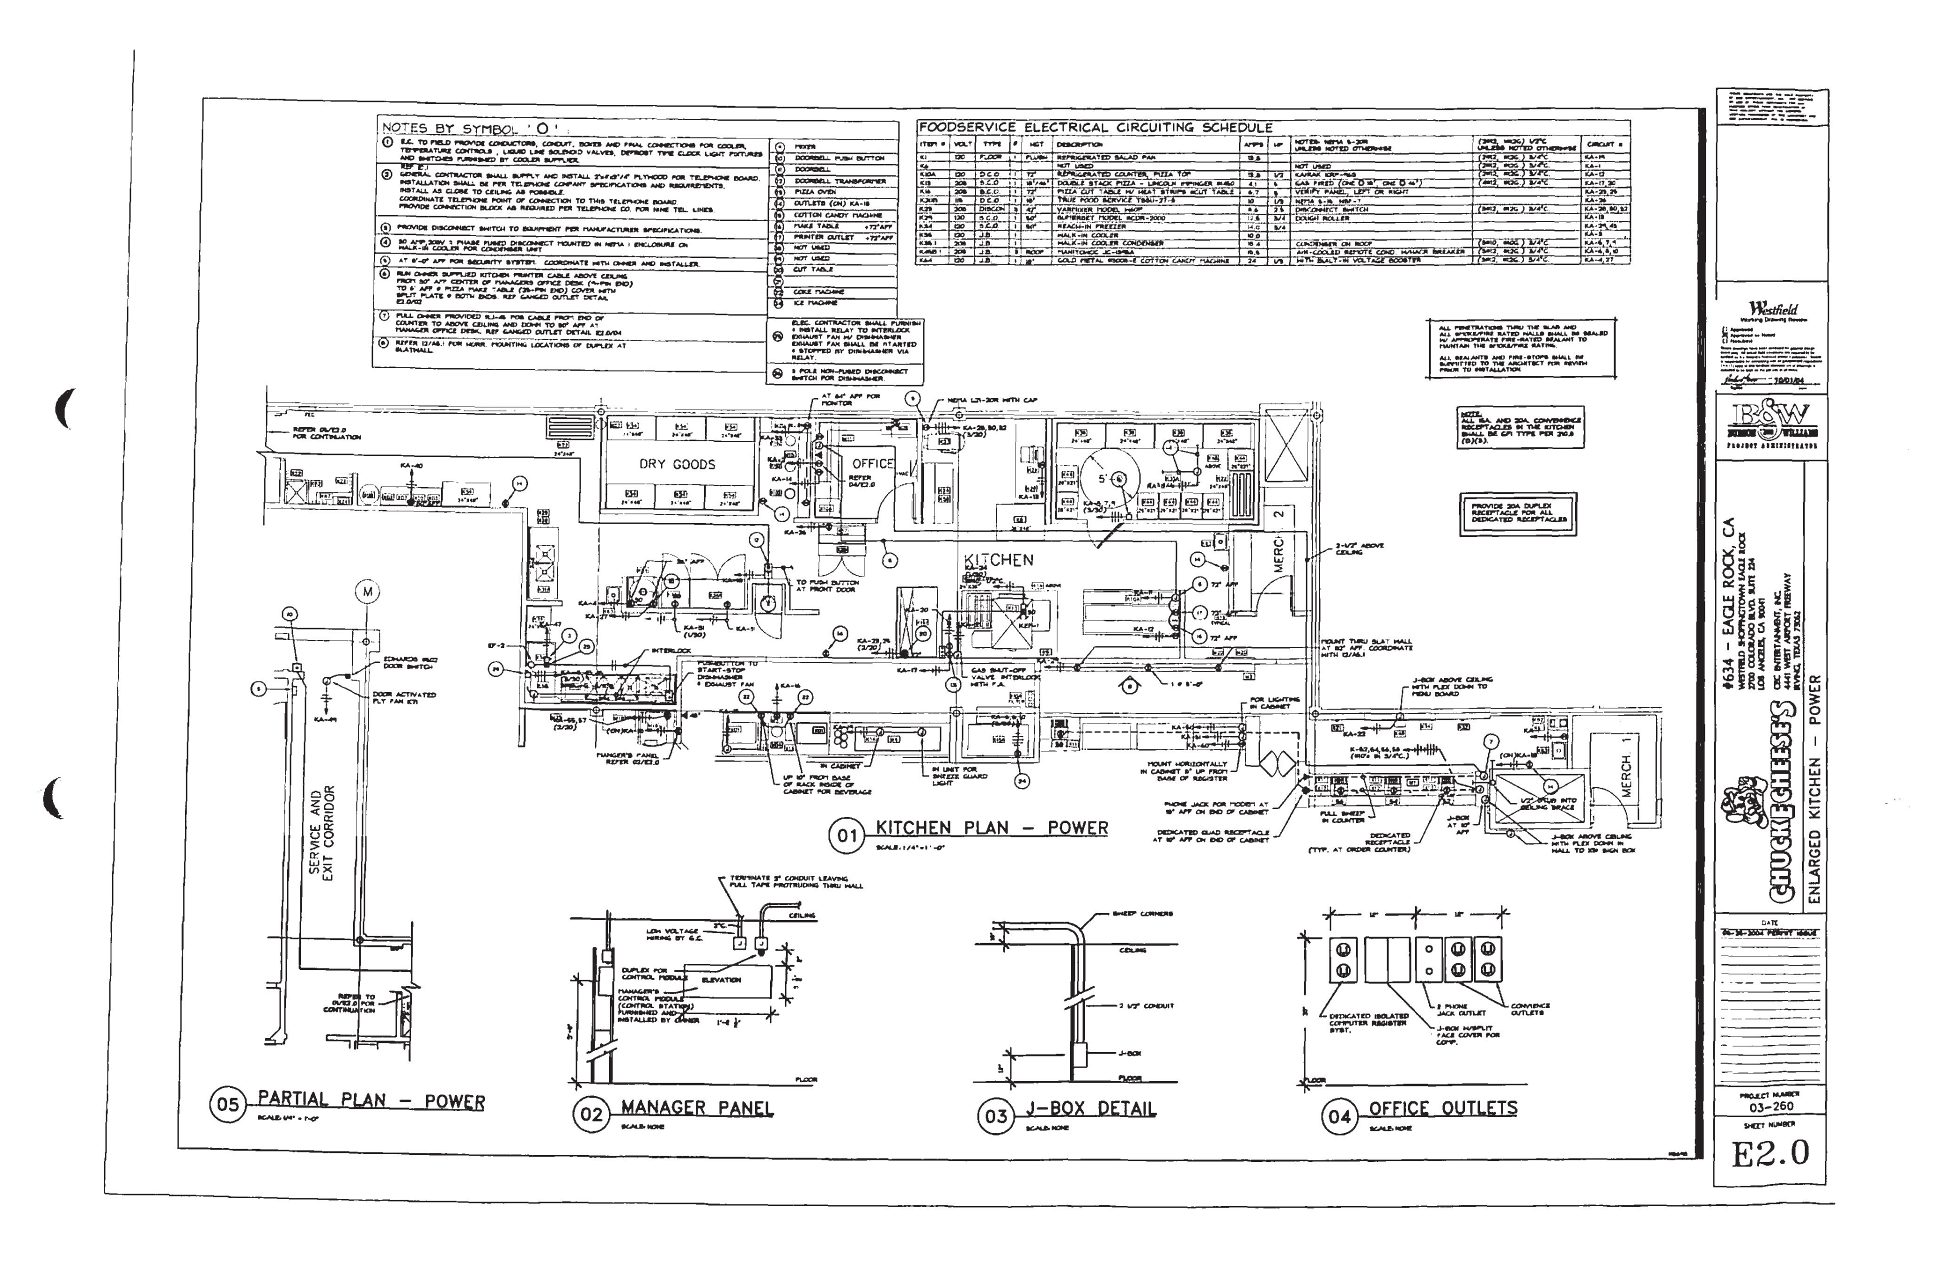
CHUCK E. CHEESE'S

FLOOR PLAN – POWER

PROJECT NUMBER
03-260

SHEET NUMBER
E1.1

B&W



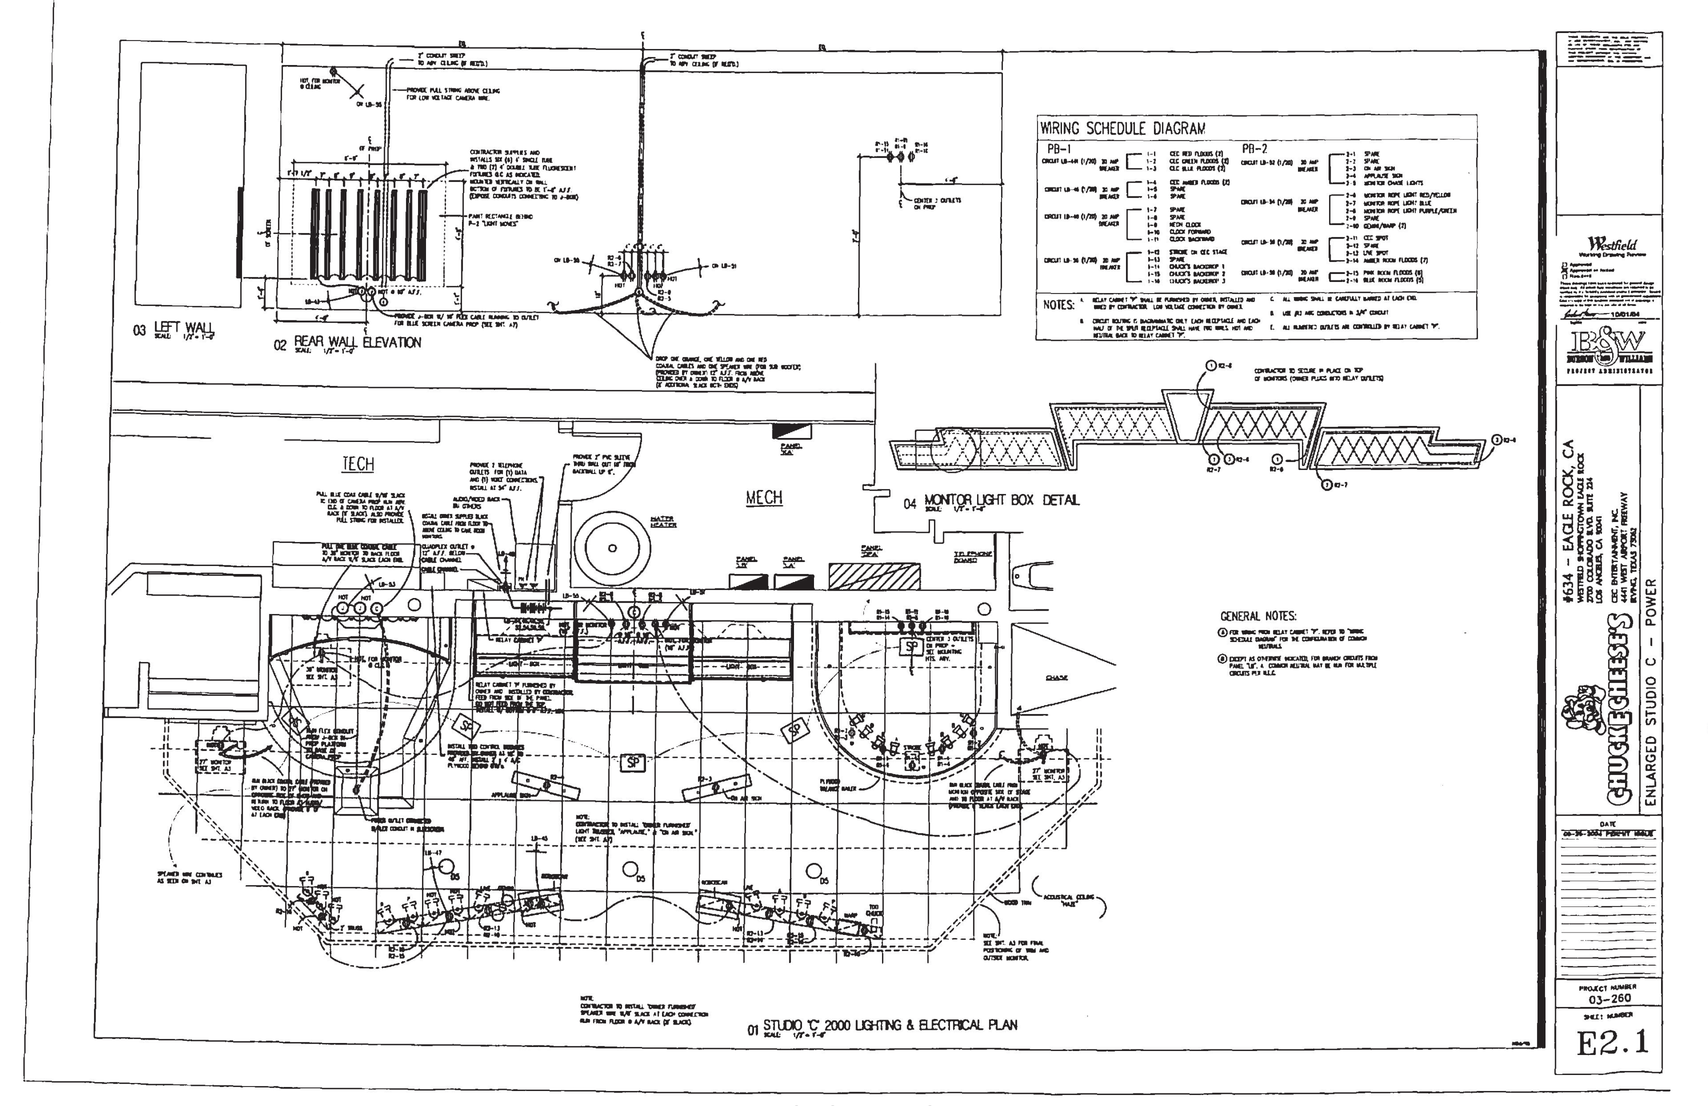
NOTES BY SYMBOL 'O':

1. E.C. TO FIELD PROVIDE CONDUCTORS, CONDUIT, BOXES AND FINAL CONNECTIONS FOR COOLER, TEMPERATURE CONTROLS, LIQUID LINE SOLENOID VALVES, DEFROST TIME CLOCK LIGHT FIXTURES AND SWITCHES FURNISHED BY COOLER SUPPLIER. REF E2.1
2. GENERAL CONTRACTOR SHALL SUPPLY AND INSTALL 2'x4'x3/4" PLYWOOD FOR TELEPHONE BOARD. INSTALLATION SHALL BE PER TELEPHONE COMPANY SPECIFICATIONS AND REQUIREMENTS. INSTALL AS CLOSE TO CEILING AS POSSIBLE. COORDINATE TELEPHONE POINT OF CONNECTION TO THIS TELEPHONE BOARD. PROVIDE CONNECTION BLOCK AS REQUIRED PER TELEPHONE CO. FOR NINE TEL. LINES.
3. PROVIDE DISCONNECT SWITCH TO EQUIPMENT PER MANUFACTURER SPECIFICATIONS.
4. 30 AMP 208V 3 PHASE FUSED DISCONNECT MOUNTED IN NEMA 1 ENCLOSURE ON WALK-IN COOLER FOR CONDENSER UNIT
5. AT 8'-0" AFF FOR SECURITY SYSTEM. COORDINATE WITH OWNER AND INSTALLER.
6. RUN OWNER SUPPLIED KITCHEN PRINTER CABLE ABOVE CEILING FROM 30" AFF CENTER OF MANAGERS OFFICE DESK (9-PIN END) TO 6' AFF @ PIZZA MAKE TABLE (25-PIN END) COVER WITH SPLIT PLATE @ BOTH ENDS. REF GANGED OUTLET DETAIL E2.0/02
7. PULL OWNER PROVIDED RJ-45 FOR CABLE FROM END OF COUNTER TO ABOVE CEILING AND DOWN TO 30" AFF AT MANAGER OFFICE DESK. REF GANGED OUTLET DETAIL E2.0/04
8. REFER 12/A6.1 FOR HORR. MOUNTING LOCATIONS OF DUPLEX AT SLATWALL.

9. MIXER
10. DOORBELL PUSH BUTTON
11. DOORBELL
12. DOORBELL TRANSFORMER
13. PIZZA OVEN
14. OUTLETS (ON) KA-18
15. COTTON CANDY MACHINE
16. MAKE TABLE +72" AFF
17. PRINTER OUTLET +72" AFF
18. NOT USED
19. NOT USED
20. CUT TABLE
21.
22. COKE MACHINE
24. ICE MACHINE
25. ELEC. CONTRACTOR SHALL FURNISH & INSTALL RELAY TO INTERLOCK EXHAUST FAN W/ DISHWASHER. EXHAUST FAN SHALL BE STARTED & STOPPED BY DISHWASHER VIA RELAY.
26. 3 POLE NON-FUSED DISCONNECT SWITCH FOR DISHWASHER.

FOODSERVICE ELECTRICAL CIRCUITING SCHEDULE

ITEM #	VOLT	TYPE	#	HGT	DESCRIPTION	AMPS	HP	NOTES: NEMA 5-20R UNLESS NOTED OTHERWISE	(2#12, #12G) 1/2"C UNLESS NOTED OTHERWISE	CIRCUIT #
K1	120	FLOOR	1	FLUSH	REFRIGERATED SALAD PAN	13.8			(2#12, #12G.) 3/4"C.	KA-14
K6			1		NOT USED			NOT USED	(2#12, #12G.) 3/4"C.	KA-1
K10A	120	D.C.O.	1	72"	REFRIGERATED COUNTER, PIZZA TOP	13.8	1/2	KAIRAK KRP-46S	(2#12, #12G.) 3/4"C.	KA-12
K13	208	S.C.O.	1	18"/46"	DOUBLE STACK PIZZA - LINCOLN IMPINGER #1450	4.1	1	GAS FIRED (ONE @ 18", ONE @ 46")	(4#12, #12G.) 3/4"C.	KA-17, 20
K16	208	S.C.O.	1	72"	PIZZA CUT TABLE W/ HEAT STRIPS @CUT TABLE	6.7	1	VERIFY PANEL, LEFT OR RIGHT		KA-23, 25
K30A	115	D.C.O.	1	18"	TRUE FOOD SERVICE TSSU-27-8	10	1/3	NEMA 5-15 NBP-7		KA-26
K28	208	DISCON	3	47"	VARIMIXER MODEL W60P	8.6	2 1/2	DISCONNECT SWITCH	(3#12, #12G.) 3/4"C.	KA-28, 30, 32
K29	120	S.C.O.	1	50"	SUPERDEET MODEL #CDR-2000	12.6	3/4	DOUGH ROLLER		KA-13
K34	120	S.C.O.	1	50"	REACH-IN FREEZER	14.0	3/4			KA-29, 43
K36	120	J.B.	1		WALK-IN COOLER	10.0				KA-3
K36.1	208	J.B.	1		WALK-IN COOLER CONDENSER	18.4		CONDENSER ON ROOF	(3#10, #10G.) 3/4"C.	KA-6, 7, 9
K46B.1	208	J.B.	3	ROOF	MANITOWOC JC-1995A	15.5		AIR-COOLED REMOTE COND. W/HACR BREAKER	(3#12, #12G.) 3/4"C.	KA-6, 8, 10
K44	120	J.B.	1	18"	GOLD METAL #5008-E COTTON CANDY MACHINE	24	1/3	WITH BUILT-IN VOLTAGE BOOSTER	(2#12, #12G.) 3/4"C.	KA-4, 27



WIRING SCHEDULE DIAGRAM
PB-1
PB-2
NOTES:
GENERAL NOTES:
03 LEFT WALL
02 REAR WALL ELEVATION
04 MONITOR LIGHT BOX DETAIL
01 STUDIO 'C' 2000 LIGHTING & ELECTRICAL PLAN
TECH
MECH
CHASE
Westfield
B&W
#634 – EAGLE ROCK, CA
WESTFIELD SHOPPINGTOWN EAGLE ROCK
2700 COLORADO BLVD. SUITE 224
LOS ANGELES, CA 90041
CEC ENTERTAINMENT, INC.
4441 WEST AIRPORT FREEWAY
IRVING, TEXAS 75062
CHUCK E. CHEESE'S
ENLARGED STUDIO C – POWER
PROJECT NUMBER
03-260
SHEET NUMBER
E2.1

PANELBOARD 'LA'

REMARKS	POLES & AMPS	LOAD WATTS	CKT	CKT	LOAD WATTS	POLES & AMPS	REMARKS
LIGHTS	1/20	1040	1	2	1500	1/20	LIGHTS
LIGHTS	1/20	1040	3	4	650	1/20	LIGHTS
LIGHTS	1/20	1128	5	6	1500	1/20	LIGHTS
LIGHTS	1/20	1650	7	8	1200	1/20	LIGHTS
LIGHTS	1/20	1560	9	10	1240	1/20	LIGHTS
LIGHTS	1/20	1275	11	12	480	1/20	LIGHTS
LIGHTS	1/20	1260	13	14	1200	1/20	LIGHTS
LIGHTS	1/20	1680	15	16	1080	1/20	LIGHTS
SIGN	1/20	1200	17	18	1200	1/20	SIGN
LOGO	1/20	1200	19	20	1200	1/20	SIGN
LOGO	1/20	1200	21	22	1000	1/20	AWNING
AWNING	1/20	1200	23	24	1000	1/20	AWNING
LIGHTS	1/20	1050	25	26	1200	1/20	EMER. LIGHTS
SPARE	1/20	—	27	28	—	1/20	SPARE
SPARE	1/20	—	29	30	—	1/20	SPARE
SPARE	1/20	—	31	32	—	1/20	SPARE
SPARE	1/20	—	33	34	—	1/20	SPARE
SPARE	1/20	—	35	36	—	1/20	SPARE
SPARE	1/20	—	37	38	—	1/20	SPARE
SPARE	1/20	—	39	40	—	1/20	SPARE
SPARE	1/20	—	41	42	—	1/20	SPARE

LIGHTING LOAD	
POWER LOAD	
TOTAL LOAD	

DESIGNATION	PANEL LA
LOCATION	MECH. ROOM
MOUNTING	SURFACE
VOLTS & PH	120/208V., 3PH, 4 WIRE
MAINS	MLO
BUSSING AMPS	100

PANELBOARD 'LB'

TWO SECTION PANEL OF 36 POLES EACH MOUNTED SIDE-BY-SIDE

REMARKS	POLES & AMPS	LOAD WATTS	CKT	CKT	LOAD WATTS	POLES & AMPS	REMARKS
GAMES	1/20	750	1	2	750	1/20	GAMES
GAMES	1/20	750	3	4	750	1/20	GAMES
GAMES	1/20	750	5	6	750	1/20	GAMES
GAMES	1/20	750	7	8	750	1/20	GAMES
GAMES	1/20	750	9	10	750	1/20	GAMES
GAMES	1/20	750	11	12	750	1/20	GAMES
GAMES	1/20	750	13	14	750	1/20	GAMES
GAMES	1/20	750	15	16	750	1/20	GAMES
TOKEN MACHINE	1/20	400	17	18	750	1/20	GAMES
GAMES	1/20	750	19	20	750	1/20	GAMES
GAMES	1/20	750	21	22	750	1/20	GAMES
GAMES	1/20	750	23	24	750	1/20	GAMES
GAMES	1/20	750	25	26	750	1/20	GAMES
GAMES	1/20	750	27	28	750	1/20	GAMES
CLEANING ⊕	1/20	1200	29	30	600	1/20	TECH. ROOM ⊕
RTU ⊕	1/20	1200	31	32	400	1/20	MONITORS
GAMES	1/20	750	33	34	1200	1/20	SKY CRAWL
WATER HEATER	1/20	1500	35	36	1000	1/20	TELE BD & SECURITY
AIR COMPRESSOR	3/30	2000	37	38	400	1/20	AIR DRYER
		2000	39	40	—	1/20	SPARE
		2000	41	42	—	1/20	SPARE
BLUE SCREEN	1/20	1200	43	44	1000	1/20	RELAY CAB. "F"
ROBOSCAN	1/20	1200	45	46	1000	1/20	RELAY CAB. "F"
ROBOSCAN	1/20	1200	47	48	1000	1/20	RELAY CAB. "F"
CABLE CH.	1/20	1440	49	50	1000	1/20	RELAY CAB. "F"
MONITORS	1/20	1400	51	52	1000	1/20	RELAY CAB. "F"
STAGE RECEPTACLES	1/20	1440	53	54	1000	1/20	RELAY CAB. "F"
MONITORS	1/20	1400	55	56	1000	1/20	RELAY CAB. "F"
GENERATOR	1/20	1200	57	58	1000	1/20	RELAY CAB. "F"
SEWAGE LIFT STATION	2/20	1000	59	60	—	1/20	SPARE
		1000	61	62	—	1/20	SPARE
SEWAGE LIFT STATION	2/20	1000	63	64	—	1/20	SPARE
		1000	65	66	—	1/20	SPARE
SPARE	1/20	—	67	68	—	1/20	SPARE
SPARE	1/20	—	69	70	—	1/20	SPARE
SPARE	1/20	—	71	72	—	1/20	SPARE

LIGHTING LOAD	
POWER LOAD	
TOTAL LOAD	

DESIGNATION	PANEL LB
LOCATION	MECH. ROOM
MOUNTING	SURFACE
VOLTS & PH	120/208V., 3PH, 4 WIRE
MAINS	MLO
BUSSING AMPS	225

PANELBOARD 'KA'

(2 SECTION PANEL, SIDE BY SIDE)

REMARKS	POLES & AMPS	LOAD WATTS	CKT	CKT	LOAD WATTS	POLES & AMPS	REMARKS
COFFEE MAKER (1) K7	1-30	2000	1	2	1000	1/20	OFFICE COMPUTER
WB. DOOR HTR, EVAP. (1) K35	1/20	800	3	4	1000	1/20	COTTON CANDY MACH. K64
WB COND. UNIT (4) K35	3/30	2000	5	6	1000	3/30	ICE MACH. (3) K40
		2000	7	8	1000		
		2000	9	10	1000		
MAKE TABLE OUTLET (1) K30	1/20	400	11	12	200	1/20	OUTLETS
DOUGH ROLLER K24	1/20	1200	13	14	1260	1/20	OFFICE OUTLETS
COKE MACHINE/CONDIMENT (2) K14	1/20	1000	15	16	1620	1/20	TEA BREWER (2) K04
PIZZA OVEN (1) K15	1/20	600	17	18	1440	1/20	OUTLETS
SNEEZE GUARD LIGHT	1/20	400	19	20	600	1/20	PIZZA OVEN (1) K15
GAS SHUT-OFF VALVE K33	1/20	200	21	22	400	1/20	MENU BOARD
CUT TABLE (4) K16	2/20	1000	23	24	1000	1/30	KEF-1
		1000	25	26	1440	1/30	REFRIG. SANDWICH TABLE K32
COTTON CANDY BOX	1/20	500	27	28	675	3/20	MIXER (4) K28
OUTLETS	1/20	1200	29	30	675		
REACH IN FREEZER K34	1/20	780	31	32	675		
BREAK AREA OUTLET	1/20	—	33	34	1660	1-30	DISHWASHER (1) K40
SPARE	1/20	—	35	36	—	1/20	SPARE
SPARE	1/20	—	37	38	—	1/20	SPARE
TELEPHONE BD., SECURITY (2) (5)	1/20	1000	39	40	1000	1/20	BAG/BOX K08
DISHWASHER	3/50	2000	41	42	—	1/20	SPARE
		2000	43	44	—	1/20	SPARE
		2000	45	46	—	1/20	SPARE
EXH. FAN 1 & 2	1/20	800	47	48	—	1/20	SPARE
FLY FAN K78	1/20	800	49	50	200	1/20	LIGHTS AT PRIZE
GIFT OUTLET	1/20	200	51	52	900	1/20	CASH REGISTER
ROOF OUTLETS	1/20	400	53	54	900	1/20	CASH REGISTER
ICE CREAM MACHINE	2/20	1560	55	56	900	1/20	CASH REGISTER
		1560	57	58	900	1/20	CASH REGISTER
SPARE	1/20	—	59	60	900	1/20	CASH REGISTER

LIGHTING LOAD	
POWER LOAD	
TOTAL LOAD	

(1) SLATWALL
(2) DOORBELL P.B.
(3) DOORBELL
(4) DOORBELL TRANSF.
(5) OUTLETS

DESIGNATION	PANEL KA
LOCATION	MECH. ROOM
MOUNTING	SURFACE
VOLTS & PH	120/208V, 3PH, 4W
MAINS	MLO
BUSSING AMPS	225

MAIN PANEL DPA

120/208 V., 3 PH., 4 WIRE
600 AMP MCB

CKT. NO	SERVES	CIRCUIT BREAKER FRAME SIZE	POLE	TRIP RATING	CONDUIT & WIRE	
1	PANEL LA	100	3	100	4# 3 IN 1-1/4" C.	
2	PANEL LB	225	3	225	4# 4/0 IN 2-1/2" C.	
3	PANEL KA	225	3	225	4# 4/0 IN 2-1/2" C.	
4	RTU-1	100	3	70	3 #4+G IN 1-1/4"C.	
5	RTU-2	100	3	70	3 #4+G IN 1-1/4"C.	
6	RTU-3	100	3	80	3 #4+G IN 1-1/4"C.	
7	RTU-4	125	3	80	3 #4+G IN 1-1/4"C.	
8	SMOKE FAN SEF-1	30	3	30	3 #10+G IN 1"C.	

GENERAL NOTES:

1. ALL BREAKERS SHALL BE THE BOLT-ON TYPE.
2. BRANCH BREAKERS OF 2P AND 3P CONFIGURATION SHALL HAVE A COMMON TRIP.
3. THE CONTRACTOR SHALL BE RESPONSIBLE FOR BALANCING THE LOADS ON ALL PANELS.
4. ALL CIRCUIT BREAKERS USED TO SWITCH LIGHT FIXTURES SHALL BE APPROVED FOR THE PURPOSE AND MARKED "SWD".
5. THE CONTRACTOR SHALL BE RESPONSIBLE FOR THE PROPER IDENTIFICATION AND LABELING OF ALL CIRCUIT BREAKERS. EACH PANEL SHALL BE PROVIDED WITH AN ACCURATE TYPEWRITTEN CIRCUIT DIRECTORY.
6. INCOMING SERVICE SHALL BE 120/208V, 3 PHASE, 4 WIRE. ANY DEVIATIONS TO THIS SERVICE TYPE SHALL NOT BE PERMITTED UNLESS APPROVED IN WRITING.
7. ALL ELECTRICAL MATERIAL USED ON THIS PROJECT SHALL BE "UL" LISTED AND LABELED.
8. ALL CONDUIT SHALL BE 1/2" UNLESS OTHERWISE NOTED.
9. THE MINIMUM SIZE OF WIRE SHALL BE #12 AWG THWN COPPER. WIRES INSTALLED UNDERGROUND OR OUTDOORS SHALL BE THW
10. ALL CONDUITS PENETRATING THE COOLER BOX SHALL BE SEALED IN COMPLIANCE WITH NEC 300-7.
11. THE CONTRACTOR SHALL ARRANGE WITH THE ELECTRIC AND TELEPHONE UTILITY CO. FOR INCOMING SERVICE REQUIREMENTS AND SHALL INCLUDE ALL COSTS IN BASE BID.
12. ALL PANELS SHALL BE PROVIDED WITH A KEY LOCK AND LATCH. EACH PANEL SHALL HAVE TWO KEYS WITH ALL PANELS KEYED ALIKE.
13. RACEWAYS SHALL BE ANY OF THE FOLLOWING MATERIALS, INSTALLED IN ACCORDANCE WITH ALL APPLICABLE CODES:
    1. TYPE MC CABLE WHERE PERMITTED IN NEC 334-3 AND INSTALLED PER 334-10.
    2. METALLIC RACEWAYS: GREENFIELD, EMT, IMC, HEAVY-WALL CONDUIT
    3. RIGID NON-METALLIC CONDUIT (COMPLY WITH NEC 347) (USE SHALL BE ONLY FOR OUTDOOR USE OR USE IN SLABS)

    ALL RACEWAYS SHALL HAVE A FULL SIZE GROUNDING CONDUCTOR INSTALLED. ROMEX, NONMETALLIC TUBING, AND BX CABLING SHALL NOT BE USED.

WESTFIELD NOTES:
CO-ORDINATE WITH MALL MANAGEMENT PRIOR TO CORING OR TRENCHING.
REPAIR FIRE-PROOFING DAMAGED DURING DEMOLITION/CONSTRUCTION AS REQUIRED TO MAINTAIN ORIGINAL RATING.
ANY UPGRADE OF EXISTING ELECTRICAL SERVICE TO BE AT TENANT SOLE EXPENSE.

RISER NOTES:

1. THE GROUNDING ELECTRODE SYSTEM SHALL CONSIST OF BONDING TOGETHER (IF AVAILABLE ON PREMISES) THE METAL UNDERGROUND WATER PIPE, CONCRETE ENCASED ELECTRODE, GROUND RING, AND ANY ROD AND/OR PIPEELECTRODES IN COMPLIANCE WITH NEC ARTICLE 250.
2. COORDINATE WITH LANDLORD AND LOCAL POWER CO. FOR COMPLETE ELECTRICAL SERVICE ENTRANCE INCLUDING METERING. FIELD VERIFY EXACT LOCATION AND INCLUDE ALL REQUIREMENTS IN BID.
3. MAIN BONDING JUMPER SHALL NOT BE SMALLER THAN #2/0 CU AND EQUIPMENT BONDING JUMPER SHALL NOT BE SMALLER THAN #2/0 CU. INSTALL AND PROVIDE PER NEC 250-102.
4. ALL ELECTRICAL PANELS SHALL BE SERIES RATED FOR 65K/10KA. IT IS THE RESPONSIBILITY OF THE ELECTRICAL CONTRACTOR TO PROPERLY LABEL ALL PANELS PER NEC.

01 ELECTRICAL RISER DIAGRAM
SCALE: NTS

Westfield Working Drawing Review
☐ Approved
☒ Approved as Noted
☐ Resubmit
10/01/04

B&W BURTON WILLIAMS PROJECT ADMINISTRATORS

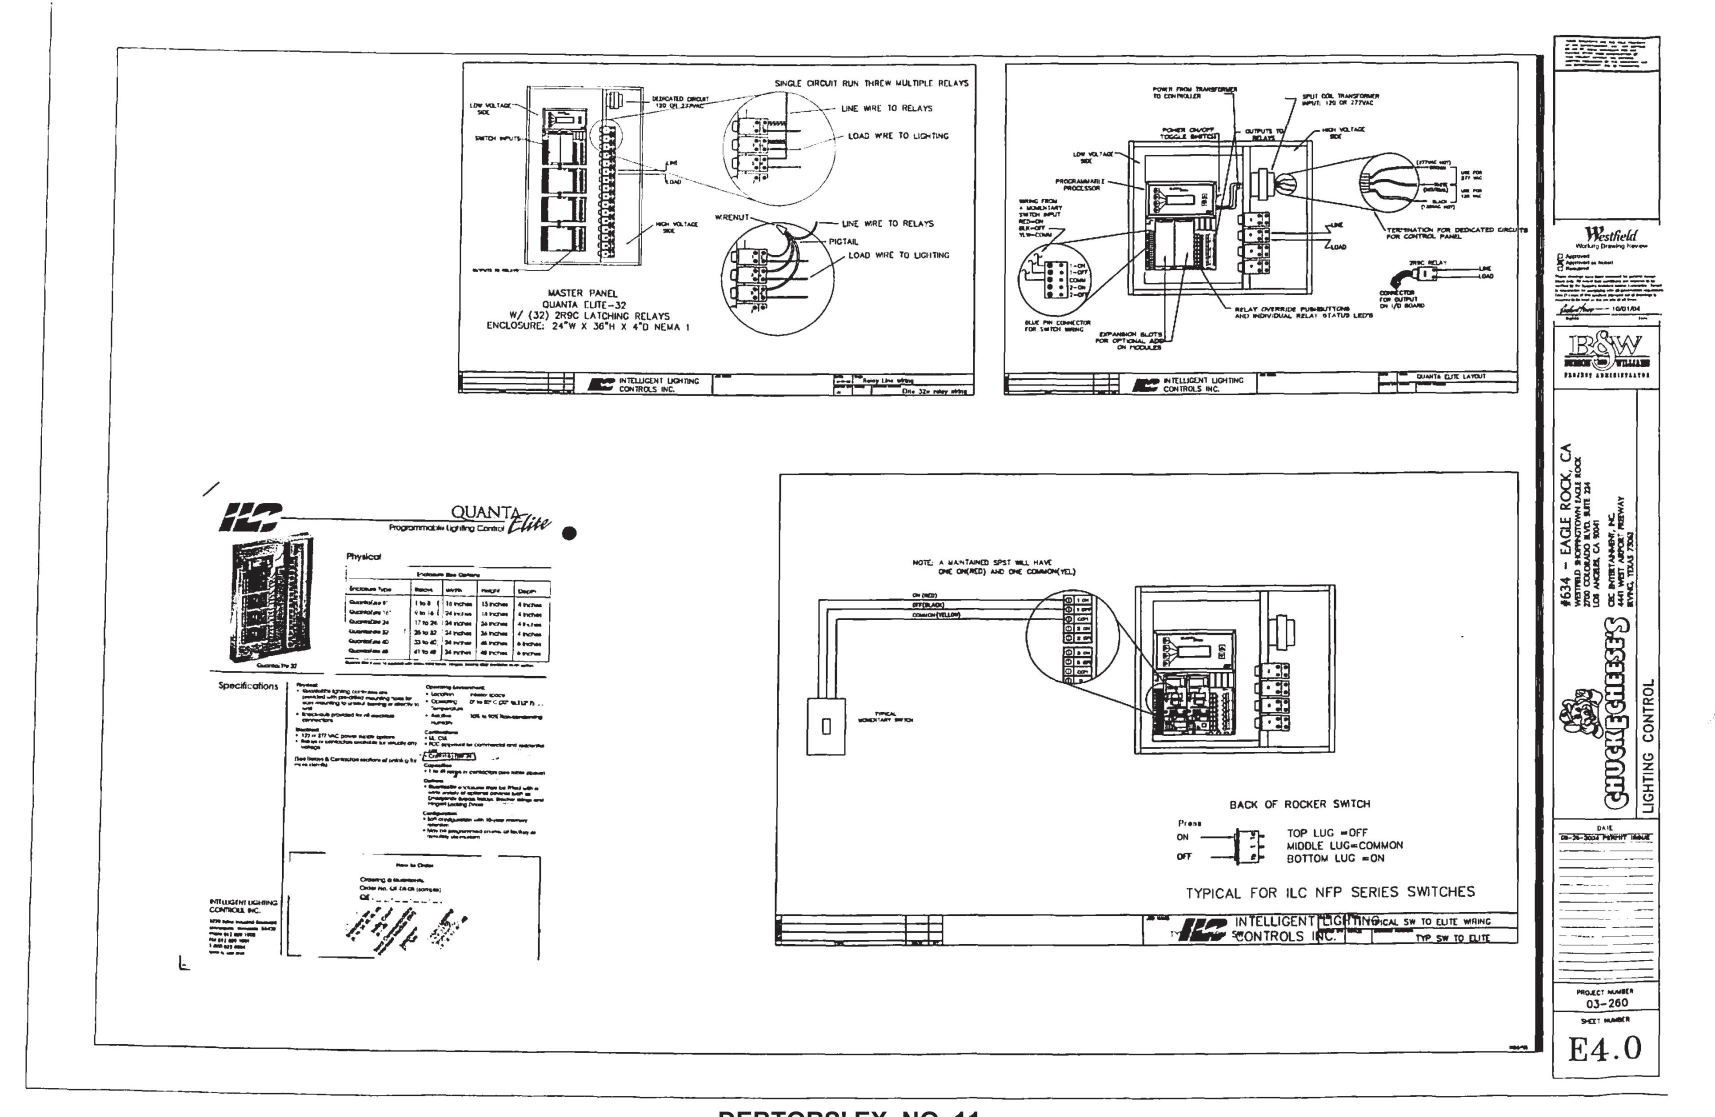
#634 – EAGLE ROCK, CA
WESTFIELD SHOPPINGTOWN EAGLE ROCK
2700 COLORADO BLVD. SUITE 224
LOS ANGELES, CA 90041

CHUCK E CHEESE'S
CEC ENTERTAINMENT, INC.
4441 WEST AIRPORT FREEWAY
IRVING, TEXAS 75062

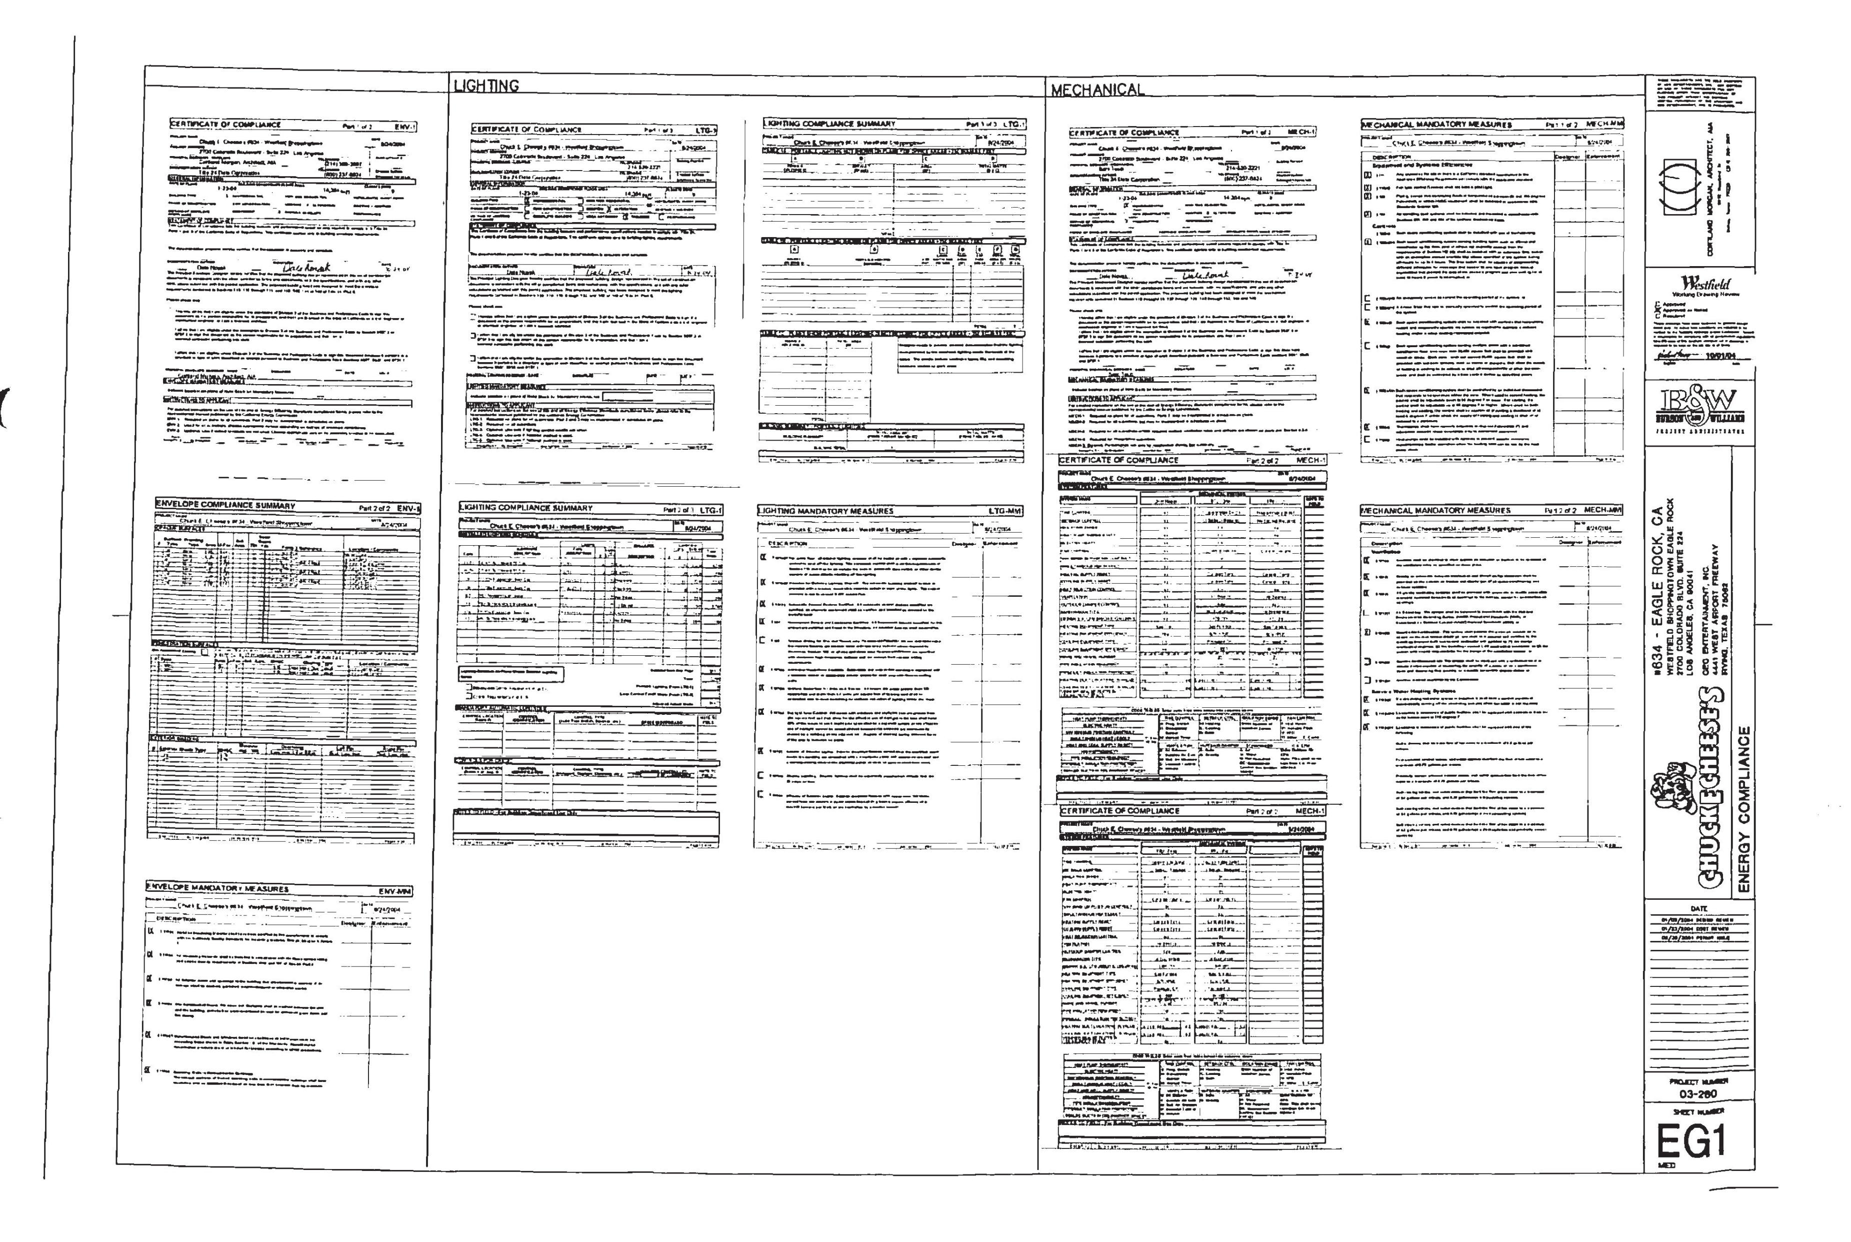
ELECTRICAL SCHEDULES & RISERS

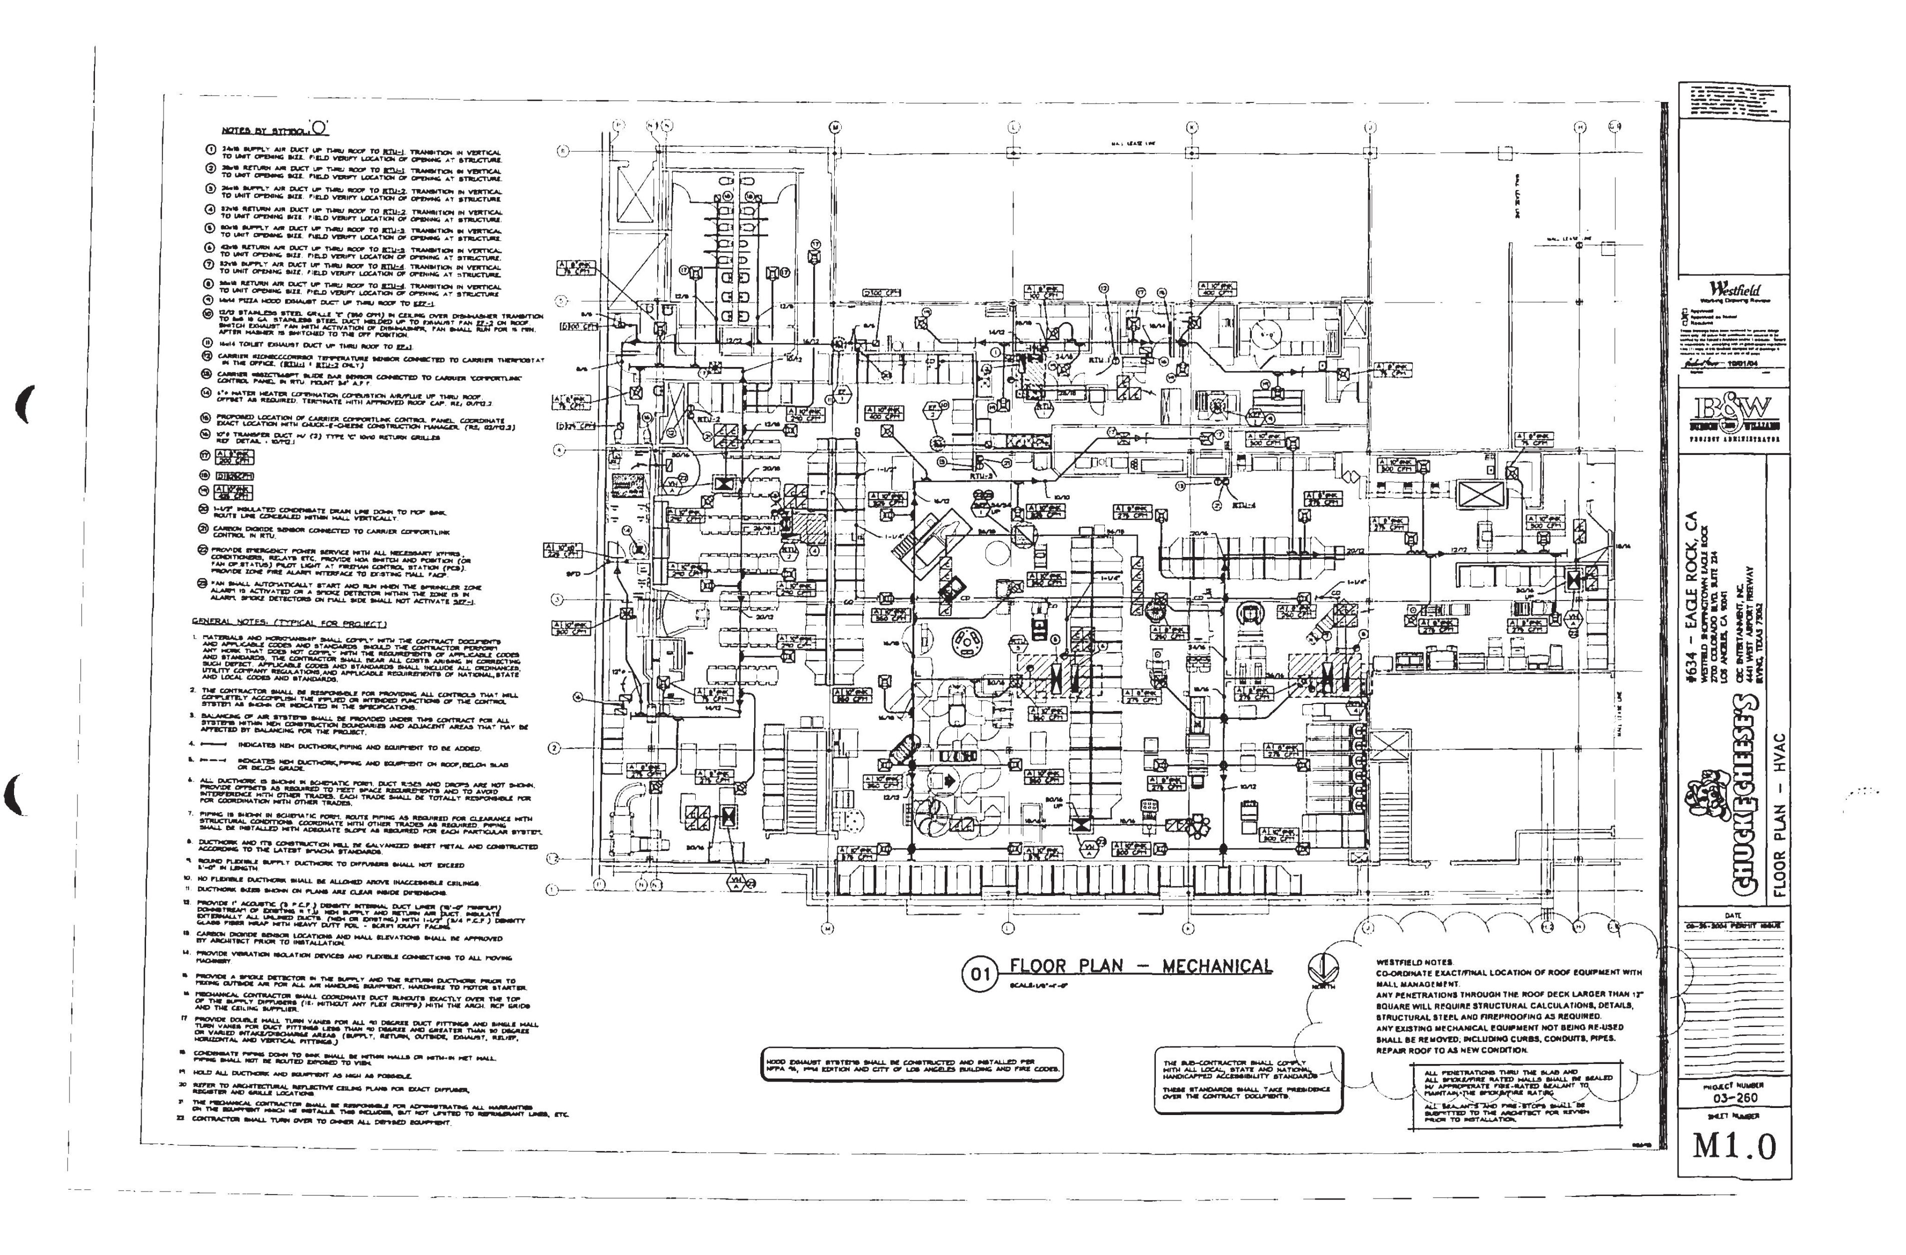
DATE
08-26-2004 PERMIT ISSUE

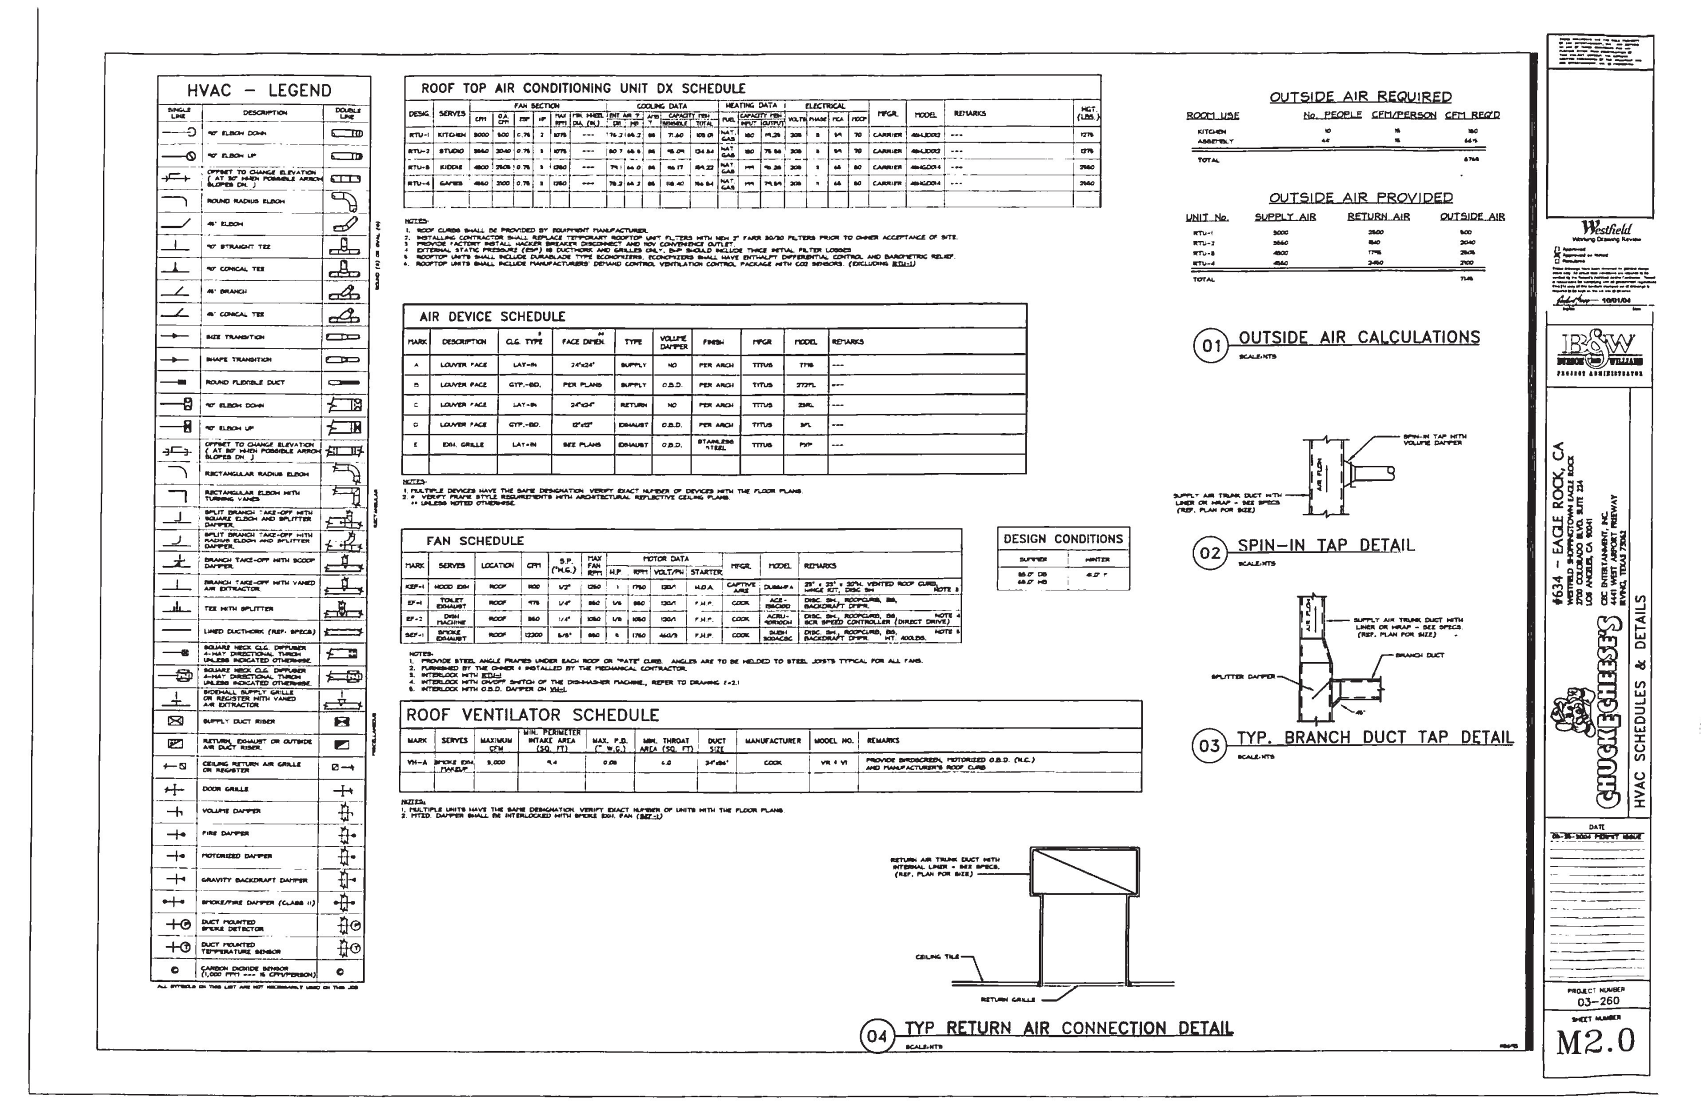
PROJECT NUMBER 03-260
SHEET NUMBER E3.1



SINGLE CIRCUIT RUN THREW MULTIPLE RELAYS
LINE WIRE TO RELAYS
LOAD WIRE TO LIGHTING
WIRENUT
PIGTAIL
LINE WIRE TO RELAYS
LOAD WIRE TO LIGHTING
MASTER PANEL
QUANTA ELITE-32
W/ (32) 2R9C LATCHING RELAYS
ENCLOSURE: 24"W X 36"H X 4"D NEMA 1
INTELLIGENT LIGHTING CONTROLS INC.
POWER FROM TRANSFORMER TO CONTROLLER
SPLIT COIL TRANSFORMER INPUT: 120 OR 277VAC
POWER ON/OFF TOGGLE SWITCH
OUTPUTS TO RELAYS
HIGH VOLTAGE SIDE
LOW VOLTAGE SIDE
PROGRAMMABLE PROCESSOR
TERMINATION FOR DEDICATED CIRCUITS FOR CONTROL PANEL
RELAY OVERRIDE PUSHBUTTONS AND INDIVIDUAL RELAY STATUS LED'S
EXPANSION SLOTS FOR OPTIONAL ADD ON MODULES
BLUE PIN CONNECTOR FOR SWITCH WIRING
QUANTA ELITE LAYOUT
QUANTA
Programmable Lighting Control
Elite
Physical
Specifications
NOTE: A MAINTAINED SPST WILL HAVE ONE ON(RED) AND ONE COMMON(YEL)
BACK OF ROCKER SWITCH
TOP LUG =OFF
MIDDLE LUG=COMMON
BOTTOM LUG =ON
Press
ON
OFF
TYPICAL FOR ILC NFP SERIES SWITCHES
TYPICAL SW TO ELITE WIRING
TYP SW TO ELITE
Westfield
Working Drawing Review
B&W
PROJECT ADMINISTRATORS
#634 - EAGLE ROCK, CA
WESTFIELD SHOPPINGTOWN EAGLE ROCK
2700 COLORADO BLVD. SUITE 224
LOS ANGELES, CA 90041
CEC ENTERTAINMENT, INC.
4441 WEST AIRPORT FREEWAY
IRVING, TEXAS 75062
CHUCK E CHEESE'S
LIGHTING CONTROL
PROJECT NUMBER
03-260
SHEET NUMBER
E4.0


CERTIFICATE OF COMPLIANCE Part 1 of 2 ENV-1
ENVELOPE COMPLIANCE SUMMARY Part 2 of 2 ENV-1
ENVELOPE MANDATORY MEASURES ENV-MM
LIGHTING
CERTIFICATE OF COMPLIANCE Part 1 of 3 LTG-1
LIGHTING COMPLIANCE SUMMARY Part 1 of 3 LTG-1
LIGHTING COMPLIANCE SUMMARY Part 2 of 3 LTG-1
LIGHTING MANDATORY MEASURES LTG-MM
MECHANICAL
CERTIFICATE OF COMPLIANCE Part 1 of 2 MECH-1
CERTIFICATE OF COMPLIANCE Part 2 of 2 MECH-1
MECHANICAL MANDATORY MEASURES Part 1 of 2 MECH-MM
MECHANICAL MANDATORY MEASURES Part 2 of 2 MECH-MM
Westfield
CORTLAND MORGAN, ARCHITECT, AIA
#634 - EAGLE ROCK, CA
WESTFIELD SHOPPINGTOWN EAGLE ROCK
2700 COLORADO BLVD. SUITE 224
LOS ANGELES, CA 90041
CHUCK E. CHEESE'S
CEC ENTERTAINMENT, INC.
4441 WEST AIRPORT FREEWAY
IRVING, TEXAS 75062
ENERGY COMPLIANCE
DATE
PROJECT NUMBER
SHEET NUMBER
EG1


NOTES BY SYMBOL: O
GENERAL NOTES: (TYPICAL FOR PROJECT)
01 FLOOR PLAN – MECHANICAL
WESTFIELD NOTES
CO-ORDINATE EXACT/FINAL LOCATION OF ROOF EQUIPMENT WITH MALL MANAGEMENT.
ANY PENETRATIONS THROUGH THE ROOF DECK LARGER THAN 12" SQUARE WILL REQUIRE STRUCTURAL CALCULATIONS, DETAILS, STRUCTURAL STEEL AND FIREPROOFING AS REQUIRED.
ANY EXISTING MECHANICAL EQUIPMENT NOT BEING RE-USED SHALL BE REMOVED, INCLUDING CURBS, CONDUITS, PIPES. REPAIR ROOF TO AS NEW CONDITION.
Westfield
B&W
#634 – EAGLE ROCK, CA
WESTFIELD SHOPPINGTOWN EAGLE ROCK
2700 COLORADO BLVD, SUITE 234
LOS ANGELES, CA 90041
CEC ENTERTAINMENT, INC.
4441 WEST AIRPORT FREEWAY
IRVING, TEXAS 75062
CHUCK E CHEESE'S
FLOOR PLAN – HVAC
PROJECT NUMBER
03-260
SHEET NUMBER
M1.0



ROOF TOP AIR CONDITIONING UNIT DX SCHEDULE

DESIG.	SERVES	FAN SECTION CFM	O.A. CFM	ESP	HP	MAX RPM	MIN. WHEEL DIA. (IN.)	COOLING DATA ENT AIR °F DB	WB	AMB °F	CAPACITY MBH SENSIBLE	TOTAL	HEATING DATA FUEL	CAPACITY MBH INPUT	OUTPUT	ELECTRICAL VOLTS	PHASE	MCA	MOCP	MFGR.	MODEL	REMARKS	WGT. (LBS.)
RTU-1	KITCHEN	3000	900	0.75	2	1075	---	76.2	64.2	95	71.60	108.01	NAT. GAS	180	[illegible]	208	3	[illegible]	70	CARRIER	48HJD008	---	1275
RTU-2	STUDIO	3660	2040	0.75	3	1075	---	80.7	66.6	95	[illegible]	124.84	NAT. GAS	180	75.86	208	3	[illegible]	70	CARRIER	48HJD008	---	1275
RTU-3	KIDDIE	4800	2505	0.75	3	1260	---	79.1	66.0	95	146.17	[illegible]	NAT. GAS	[illegible]	[illegible]	208	3	65	80	CARRIER	48HGD014	---	2560
RTU-4	GAMES	4560	2100	0.75	3	1260	---	78.2	64.2	95	118.40	166.84	NAT. GAS	[illegible]	79.84	208	3	65	80	CARRIER	48HGD014	---	2560

NOTES:
1. ROOF CURBS SHALL BE PROVIDED BY EQUIPMENT MANUFACTURER.
2. INSTALLING CONTRACTOR SHALL REPLACE TEMPORARY ROOFTOP UNIT FILTERS WITH NEW 2" FARR 30/30 FILTERS PRIOR TO OWNER ACCEPTANCE OF SITE.
3. PROVIDE FACTORY INSTALL HACKER BREAKER DISCONNECT AND 110V CONVENIENCE OUTLET.
4. EXTERNAL STATIC PRESSURE (ESP) IS DUCTWORK AND GRILLES ONLY. BHP SHOULD INCLUDE THICE INITIAL FILTER LOSSES
5. ROOFTOP UNITS SHALL INCLUDE DURABLADE TYPE ECONOMIZERS. ECONOMIZERS SHALL HAVE ENTHALPY DIFFERENTIAL CONTROL AND BAROMETRIC RELIEF.
6. ROOFTOP UNITS SHALL INCLUDE MANUFACTURERS' DEMAND CONTROL VENTILATION CONTROL PACKAGE WITH CO2 SENSORS. (EXCLUDING RTU-1)

AIR DEVICE SCHEDULE

MARK	DESCRIPTION	CLG. TYPE *	FACE DIMEN. **	TYPE	VOLUME DAMPER	FINISH	MFGR	MODEL	REMARKS
A	LOUVER FACE	LAY-IN	24"x24"	SUPPLY	NO	PER ARCH	TITUS	TMS	---
B	LOUVER FACE	GYP.-BD.	PER PLANS	SUPPLY	O.B.D.	PER ARCH	TITUS	272FL	---
C	LOUVER FACE	LAY-IN	24"x24"	RETURN	NO	PER ARCH	TITUS	23RL	---
D	LOUVER FACE	GYP.-BD.	12"x12"	EXHAUST	O.B.D.	PER ARCH	TITUS	3FL	---
E	EXH. GRILLE	LAY-IN	SEE PLANS	EXHAUST	O.B.D.	STAINLESS STEEL	TITUS	PXP	---

NOTES:
1. MULTIPLE DEVICES HAVE THE SAME DESIGNATION. VERIFY EXACT NUMBER OF DEVICES WITH THE FLOOR PLANS.
2. * VERIFY FRAME STYLE REQUIREMENTS WITH ARCHITECTURAL REFLECTIVE CEILING PLANS.
** UNLESS NOTED OTHERWISE.

FAN SCHEDULE

MARK	SERVES	LOCATION	CFM	S.P. ("W.G.)	MAX FAN RPM	MOTOR DATA H.P.	RPM	VOLT/PH	STARTER	MFGR.	MODEL	REMARKS
KEF-1	HOOD EXH	ROOF	1100	1/2"	1250	1	1750	120/1	H.O.A.	CAPTIVE AIRE	DU85HFA	23" x 23" x 20"H. VENTED ROOF CURB, HINGE KIT, DISC SW NOTE 3
EF-1	TOILET EXHAUST	ROOF	475	1/4"	860	1/6	860	120/1	F.H.P.	COOK	ACE-135C10D	DISC. SW., ROOFCURB, BS, BACKDRAFT DMPR.
EF-2	DISH MACHINE	ROOF	860	1/4"	1050	1/8	1050	120/1	F.H.P.	COOK	ACRU-100D	DISC. SW., ROOFCURB, BS, NOTE 4 SCR SPEED CONTROLLER (DIRECT DRIVE)
SEF-1	SMOKE EXHAUST	ROOF	12300	5/8"	860	5	1750	460/3	F.H.P.	COOK	SUBH 300ACBC	DISC. SW., ROOFCURB, BS, NOTE 5 BACKDRAFT DMPR. WT. 400LBS.

NOTES:
1. PROVIDE STEEL ANGLE FRAMES UNDER EACH ROOF OR "PATE" CURB. ANGLES ARE TO BE WELDED TO STEEL JOISTS TYPICAL FOR ALL FANS.
2. FURNISHED BY THE OWNER & INSTALLED BY THE MECHANICAL CONTRACTOR.
3. INTERLOCK WITH RTU-1
4. INTERLOCK WITH ON/OFF SWITCH OF THE DISHWASHER MACHINE., REFER TO DRAWING E-2.1
5. INTERLOCK WITH O.B.D. DAMPER ON VH-1.

DESIGN CONDITIONS

SUMMER	WINTER
95.0° DB 68.0° WB	41.0° F

ROOF VENTILATOR SCHEDULE

MARK	SERVES	MAXIMUM CFM	MIN. PERIMETER INTAKE AREA (SQ. FT)	MAX. P.D. (" W.G.)	MIN. THROAT AREA (SQ. FT)	DUCT SIZE	MANUFACTURER	MODEL NO.	REMARKS
VH-A	SMOKE EXH. MAKEUP	9,000	9.4	0.08	6.0	34"x36"	COOK	VR + VI	PROVIDE BIRDSCREEN, MOTORIZED O.B.D. (N.C.) AND MANUFACTURER'S ROOF CURB

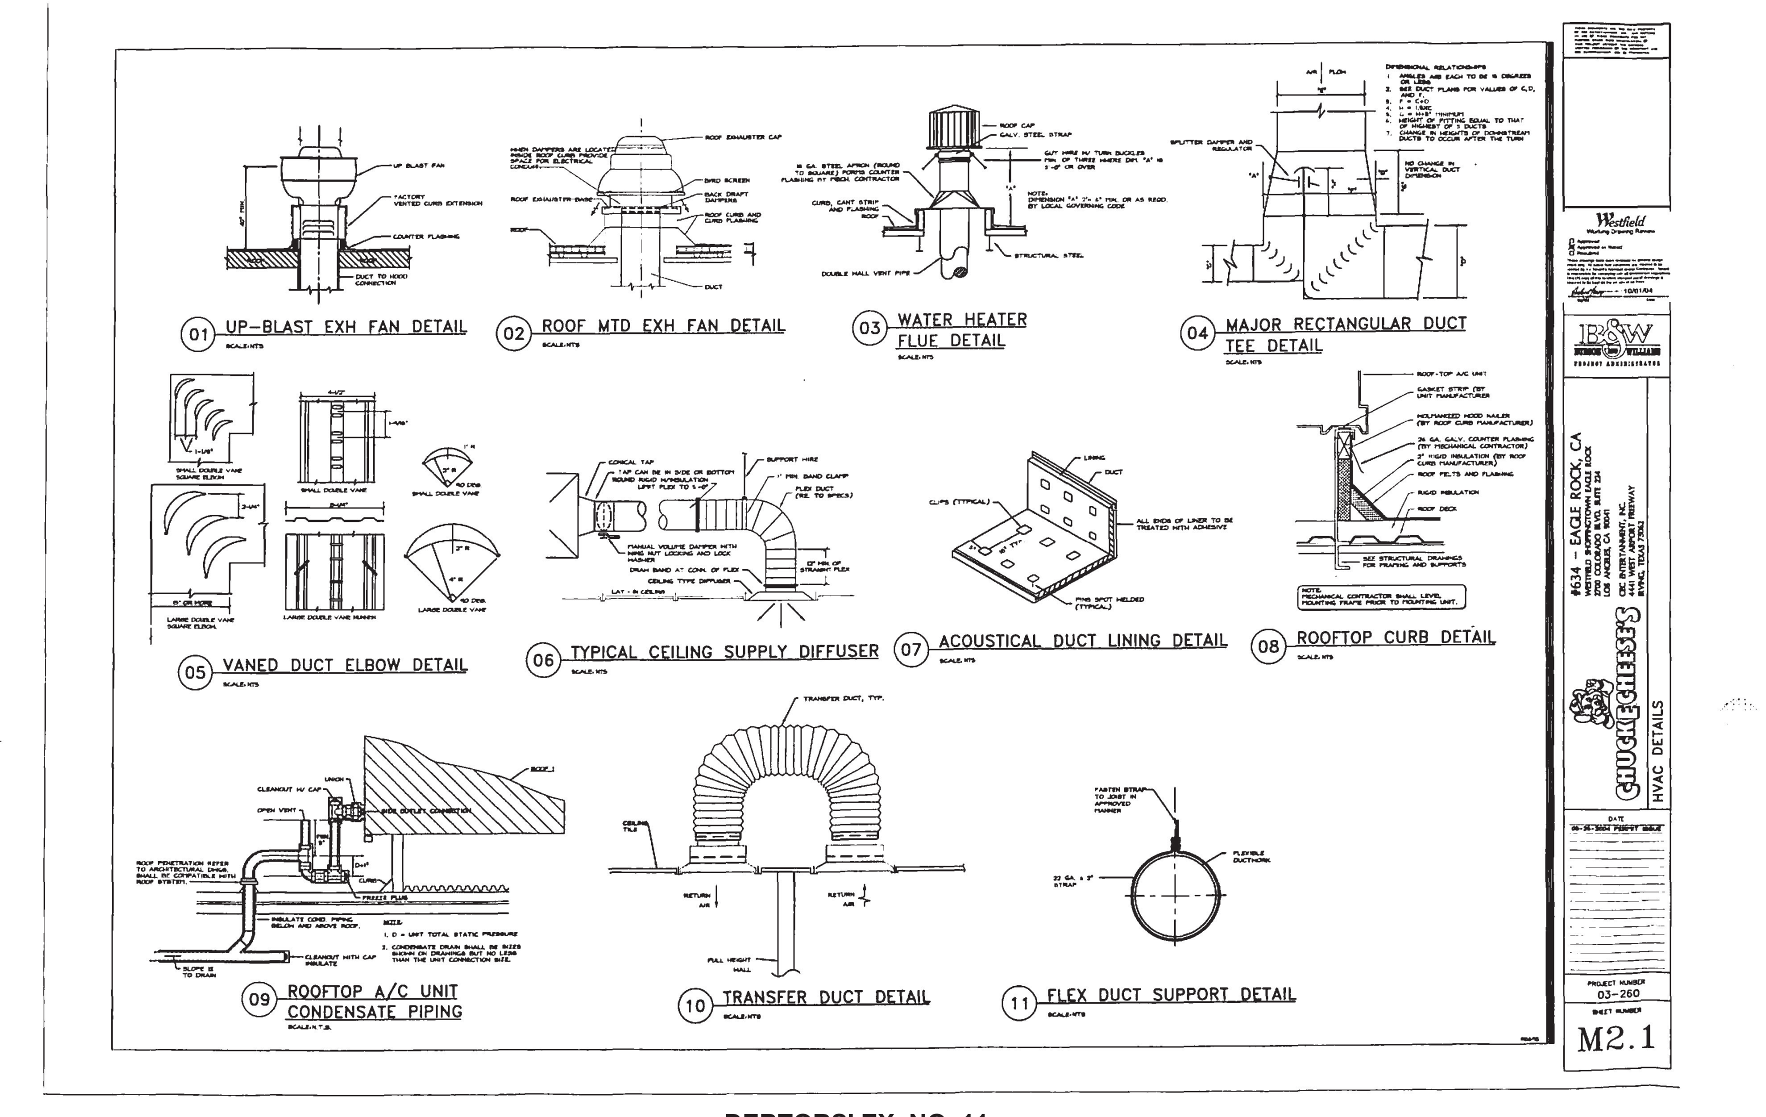
NOTES:
1. MULTIPLE UNITS HAVE THE SAME DESIGNATION. VERIFY EXACT NUMBER OF UNITS WITH THE FLOOR PLANS.
2. MTZD. DAMPER SHALL BE INTERLOCKED WITH SMOKE EXH. FAN (SEF-1)

OUTSIDE AIR REQUIRED

ROOM USE	No. PEOPLE	CFM/PERSON	CFM REQ'D
KITCHEN	10	15	150
ASSEMBLY	44	15	6615
TOTAL			6765

OUTSIDE AIR PROVIDED

UNIT No.	SUPPLY AIR	RETURN AIR	OUTSIDE AIR
RTU-1	3000	2500	900
RTU-2	3660	840	2040
RTU-3	4800	1775	2505
RTU-4	4560	2450	2100
TOTAL			7145



DEBTORS' EX. NO. 11
Page 114 of 130

EXHAUST TERMINAL

SEAL WITH HIGH TEMP. SILICONE RUBBER SEALANT

COMBUSTION AIR INLET

FLASHING

ROOF THIMBLE

ROOF

SINGLE WALL FLUE EXHAUST DUCT

CONCENTRIC ADAPTER

COMBUSTION AIR DUCT

01 VENT/COMB AIR THRU ROOF DETAIL

SCALE: NOT TO SCALE

THERMOSTAT | THERMOSTAT

RTU-1 KITCHEN | RTU-2 STUDIO

CONTROLS LAYOUT

UNIT #
MODEL
S/N
ELEC
GAS

TYPICAL ENGRAVED ALUMINUM INFORMATION PLATE TO BE POP-RIVETED ON EACH UNIT.

FOOTNOTES:

1. THE LAYOUT SHOWN ABOVE SHALL BE PROVIDED BY THE INSTALLING CONTRACTOR WITH THERMOSTATS PROVIDED BY CARRIER CORPORATION. THE INSTALLING CONTRACTOR SHALL MOUNT THE THERMOSTATS IN THE FIELD SUPPLIED PANEL WHICH SHALL BE LOCATED IN THE MANAGERS OFFICE. EACH THERMOSTAT SHALL BE CLEARLY MARKED FOR THE ROOFTOP UNIT WHICH IT CONTROLS BY THE INSTALLING CONTRACTOR.
2. THERMOSTATS SHALL BE CARRIER MODEL (38CSPTN-02) WITH AUTOMATIC CHANGEOVER, 3 STAGES HEATING, TWO STAGES OF COOLING AND SEVEN DAY NIGHT SET BACK WITH TIME GUARD FUNCTION. REMOTE SENSOR SHALL BE MODEL (ZONECCORRS01).

02 CEC ENTERTAINMENT REMOTE CONTROLS DETAIL (RTU-1 & 2 ONLY)

SCALE: N.T.S.

VH A

BASE FLASHING TYP.

5/8"x4" LAG BOLT THRU BLOCKING AT 12" O.C. EACH END

4"x6" BLOCKING BETWEEN ROOF FRAMING, SECURE W/ SIMPSON HU34 JOIST HANGER AT EACH END

ROOF FRAMING

FRAME AROUND ROOF OPENING WITH (2) 2x DEPTH OF ROOF FRAMING

M.V.D (N.C.) INTERLOCKED TO FAN (SEF-)

03 GRAVITY VENT DETAIL

SCALE: NOT TO SCALE

Westfield Working Drawing Review

B&W BENSON AND WILLIAMS PROJECT ADMINISTRATOR

CHUCK E. CHEESE'S

#634 - EAGLE ROCK, CA
WESTFIELD SHOPPINGTOWN EAGLE ROCK
2700 COLORADO BLVD. SUITE 234
LOS ANGELES, CA 90041

CEC ENTERTAINMENT, INC.
4441 WEST AIRPORT FREEWAY
IRVING, TEXAS 75062

HVAC DETAILS

DATE
08-26-2004 PERMIT ISSUE

PROJECT NUMBER
03-260

SHEET NUMBER
M2.2

ROBINSONS · MAY
(EXISTING)
CEC #634
1 STORY, SECOND LEVEL
TENANT FINISH-OUT
14,806 SF
TARGET
(EXISTING)
LEVEL 2 ENCLOSED MALL (EXISTING)
ROCK GLEN AVENUE
01 SITE PLAN – MEP
NOTES BY SYMBOL 'O'
1 GALLON GREASE INTERCEPTOR, REF. DETAL (FIELD VERIFY EXACT LOCATION)
2 TWO-WAY CLEANOUT, REF. DETAIL
3 TEST WELL SAMPLE PORT, REF. DETAIL
4 4" LOCAL VENT FROM GREASE INTERCEPTOR (FIELD VERIFY LOCATION)
6 FIRE RISER (FIELD VERIFY LOCATION)
7 4" GREASE WASTE STACK, TO SERVE CEC ON SECOND LEVEL. FIELD VERIFY LOCATION WITH FIRST LEVEL TENANT AND ARCHITECT.
8 VENT FROM LIFT STATION
CO-ORDINATE EXACT LOCATION OF GREASE INTERCEPTOR WITH MALL MANAGEMENT; INCLUDING VENTS.
CO-ORDINATE STACK LOCATION WITH LOWER TENANT AND MALL MANAGEMENT.
Westfield
Working Drawing Review
Approved
Approved as Noted
Resubmit
10/01/04
B&W
#634 – EAGLE ROCK, CA
CHUCK E. CHEESE'S
SITE PLAN – MEP
PROJECT NUMBER
03-260
SHEET NUMBER
MEP0.0

GENERAL NOTES:

1. PLUMBING CONTRACTOR TO FIELD VERIFY ALL EXISTING CONDITIONS AND ACTUAL LOCATION OF UTILITIES.
2. PLUMBING CONTRACTOR TO COORDINATE ALL INSTALLATION WORK WITH GENERAL CONTRACTOR, LANDLORD AND GAS UTILITY CO.

PROPOSED LOCATION OF ROOFTOP EQUIPMENT BY OTHERS (FIELD VERIFY)

NOTES BY SYMBOL:

1. LANDLORD PROVIDED GAS SERVICE LINE. FIELD VERIFY EXACT LOCATION.
2. APPROXIMATE CONNECTION POINT, FIELD VERIFY.
3. -- NOT USED --
4. LOW PRESSURE GAS PIPING DOWN THRU ROOF AND CEILING SPACE TO PIZZA OVEN. PROVIDE GAS COCK, UNION, AND DIRT LEG AT CONNECTION. SEE DETAIL 10/P3.1.
5. GAS PIPING DOWN THRU ROOF AND CEILING SPACE TO WATER HEATER. PROVIDE GAS COCK, UNION, AND DIRT LEG AT CONNECTION. SEE DETAIL 04/P3.0.
6. LOW PRESSURE GAS CONNECTION TO ROOF TOP UNIT (TYPICAL). PROVIDE GAS COCK, UNION, AND DIRT LEG AT CONNECTION. SEE GAS CONNECTION DETAIL 17/P3.1.
7. LOW PRESSURE GAS PIPING ON ROOF. PROVIDE PIPE SUPPORTS. SEE PIPE SUPPORT DETAIL 16/P3.1.
8. -- NOT USED --
9. PLUMBING VENT THRU ROOF. INSTALL 10'-0" CLEAR FROM ANY FRESH AIR INTAKE ON ROOF (RTU's, SUPPLY AIR FANS, ETC.). SEE VENT DETAIL 18/P3.1.
10. PROPOSED LOCATIONS OF CONDENSING UNITS FOR WALK-IN COOLERS AND ICE MACHINE. REFER TO SHEET E2.0 FOR POWER REQUIREMENTS.
11. W.P. GFI OUTLET AT RTU. CONNECT TO LB-31.
12. SMOKE AND PRODUCTS OF COMBUSTION DETECTOR MOUNTED IN SUPPLY AIR DUCT OF ROOF-TOP UNIT TO DE-ENERGIZE UNIT IN CASE OF ACTIVATION. ALL RTU's HAVE MANUFACTURER FURNISHED DISCONNECTS & CONVENIENCE RECEPTACLE.

GAS DEMAND SCHEDULE

TAG	ITEM	DEMAND
-	RTU-1	180 CFH
-	RTU-2	180 CFH
-	RTU-3	[illegible] CFH
-	RTU-4	[illegible] CFH
-	WH-1	[illegible] CFH
K13	PIZZA OVEN 2 @ 120	240 CFH
-	TOTAL =	1,[illegible] CFH

LOW PRESSURE GAS

GAS PIPING SYSTEM SIZED FROM THE 2000 UNIFORM PLUMBING CODE BASE ON 200' (MAX.) TOTAL LENGTH UNDER (1) POUND 4 OZ./S" WC

VERIFY EXACT VENT LOCATION WITH LOWER TENANT EQUIPMENT.

MALL RTU #2

EXISTING ROOFTOP EQUIPMENT TO REMAIN - FIELD VERIFY (TYP.)

CD LINE BELOW ROOF ROUTE INSIDE (TYPICAL)

REFER TO OVES.) FOR ELECT. CONN.

MFR. COMBINATION EXHAUST

01 ROOF PLAN – MEP

SCALE: 1/8"=1'-0"

WESTFIELD NOTES:

TENANT GENERAL CONTRACTOR WILL BE REQUIRED TO FURNISH TEMPORARY WEATHERPROOFING FOR ALL ROOF PENETRATIONS, UNTIL TIME WHEN LANDLORD ROOFING CONTRACTOR HAS COMPLETED WORK AND FINAL PATCH.

ANY PENETRATION THROUGH DECK LARGER THAN 12" SQUARE WILL R STRUCTURAL CALCULATIONS, DETAILS, STRUCTURAL STEEL, AND FIREPROOFING.

Westfield
Working Drawing Review

☐ Approved
☒ Approved as Noted
☐ Resubmit

10/01/04

B&W Project Administrator

CHUCK E. CHEESE'S

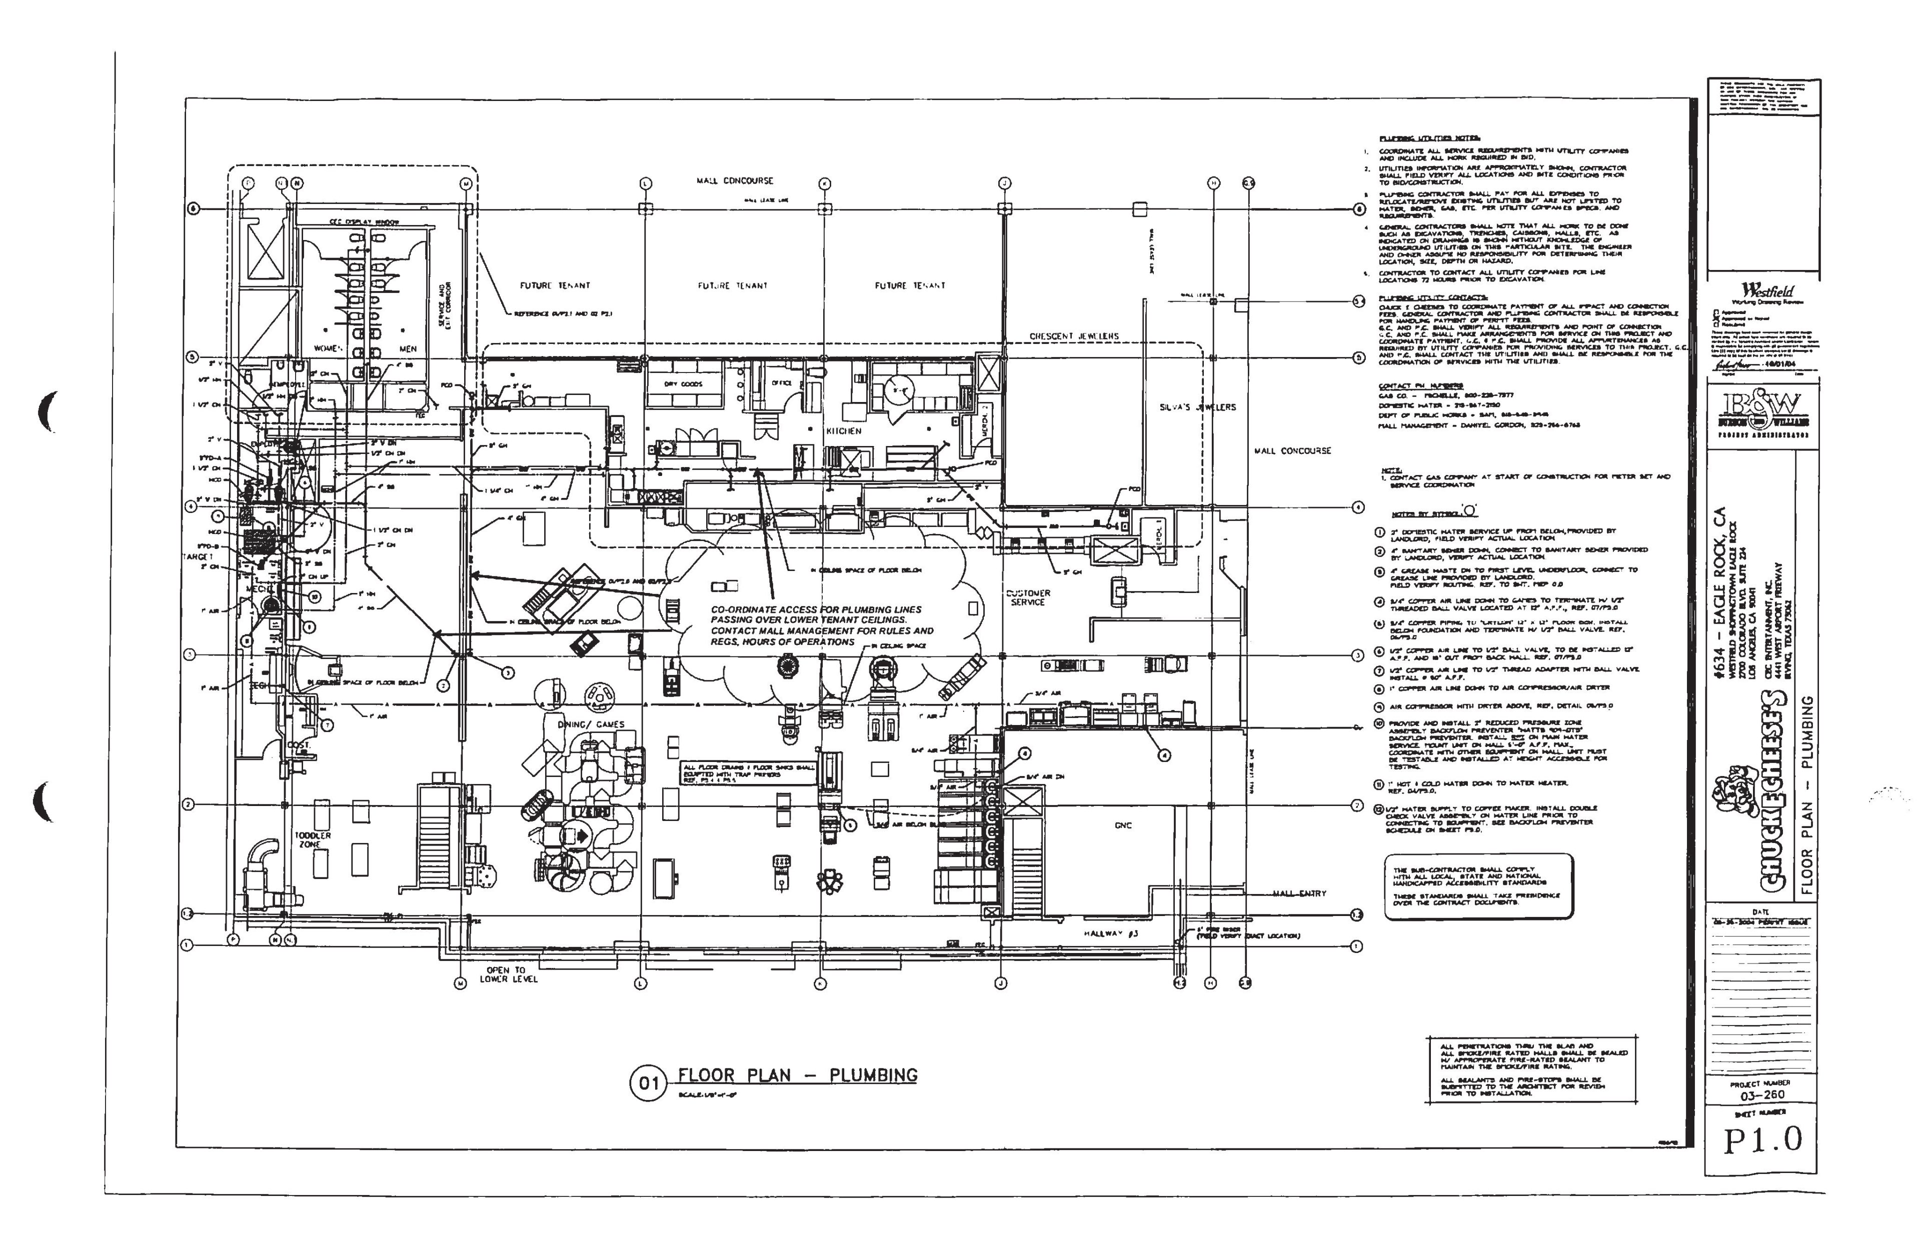
#634 – EAGLE ROCK, CA
WESTFIELD SHOPPINGTOWN EAGLE ROCK
2700 COLORADO BLVD. SUITE 224
LOS ANGELES, CA 90041

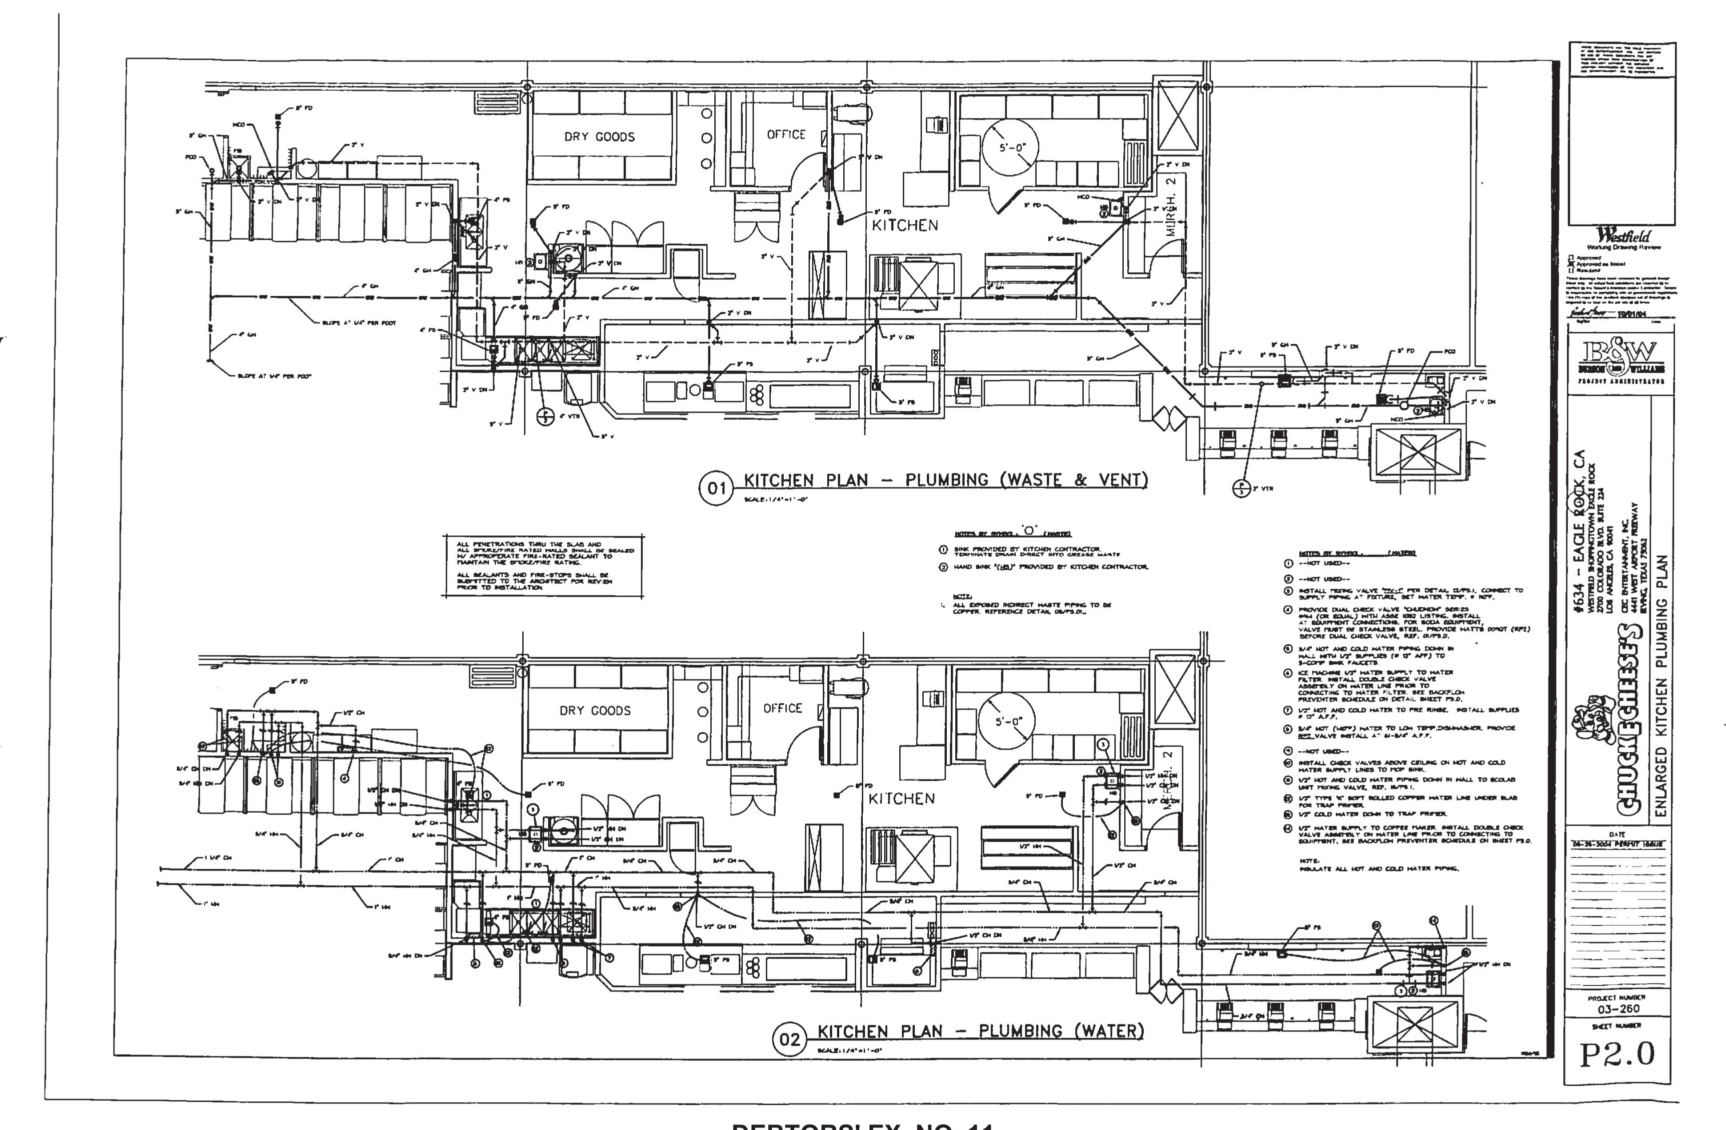
CEC ENTERTAINMENT, INC.
4441 WEST AIRPORT FREEWAY
IRVING, TEXAS 75062

ROOF PLAN – HVAC

PROJECT NUMBER 03-260

SHEET NUMBER MEP1.0


MALL CONCOURSE
FUTURE TENANT
FUTURE TENANT
FUTURE TENANT
CRESCENT JEWELERS
SILVA'S JEWELERS
MALL CONCOURSE
WOMEN
MEN
SERVICE AND EXIT CORRIDOR
DRY GOODS
OFFICE
KITCHEN
CUSTOMER SERVICE
CO-ORDINATE ACCESS FOR PLUMBING LINES PASSING OVER LOWER TENANT CEILINGS. CONTACT MALL MANAGEMENT FOR RULES AND REGS, HOURS OF OPERATIONS
DINING/ GAMES
TODDLER ZONE
GNC
MALL ENTRY
HALLWAY #3
OPEN TO LOWER LEVEL
01 FLOOR PLAN – PLUMBING
Westfield
B&W
#634 – EAGLE ROCK, CA
WESTFIELD SHOPPINGTOWN EAGLE ROCK
2700 COLORADO BLVD. SUITE 224
LOS ANGELES, CA 90041
CEC ENTERTAINMENT, INC.
4441 WEST AIRPORT FREEWAY
IRVING, TEXAS 75062
CHUCK E. CHEESE'S
FLOOR PLAN – PLUMBING
PROJECT NUMBER
03-260
SHEET NUMBER
P1.0


DRY GOODS
OFFICE
KITCHEN
5'-0"
MURCH. 2
01 KITCHEN PLAN – PLUMBING (WASTE & VENT)
02 KITCHEN PLAN – PLUMBING (WATER)
Westfield
B&W
#634 - EAGLE ROCK, CA
CHUCK E. CHEESE'S
ENLARGED KITCHEN PLUMBING PLAN
PROJECT NUMBER
03-260
SHEET NUMBER
P2.0

CEC DISPLAY WINDOW

WOMEN

MEN

SERVICE AND EXIT CORRIDOR

EMPLOYEE

FEC

01 KITCHEN PLAN – PLUMBING (WASTE & VENT)

SCALE: 1/4"=1'-0"

CEC DISPLAY WINDOW

WOMEN

MEN

SERVICE AND EXIT CORRIDOR

EMPLOYEE

FEC

02 KITCHEN PLAN – PLUMBING (WATER)

SCALE: 1/4"=1'-0"

NOTES BY SYMBOL 'O' (WATER)

1. WATER PIPING IN WALL TO TOILET ROOM FIXTURES. PROVIDE HAMMER ARRESTER AND ACCESS PANEL. LOCATED IN MEN'S ROOM. INSTALL ABOVE FLOOR TILE BASE AND BELOW GRAB BAR, 24" OFF CENTER OF TOILET.
2. INSTALL MIXING VALVE "TV-1" PER DETAIL 12/P3.1, CONNECT TO SUPPLY PIPING AT FIXTURE, SET WATER TEMP. @ 110°F.
3. 1/2" COLD WATER DOWN TO TRAP PRIMER.
4. 1/2" TYPE 'K' SOFT ROLLED COPPER WATER LINE UNDER SLAB FOR TRAP PRIMER.

ALL PENETRATIONS THRU THE SLAB AND ALL SMOKE/FIRE RATED WALLS SHALL BE SEALED W/ APPROPRIATE FIRE-RATED SEALANT TO MAINTAIN THE SMOKE/FIRE RATING.

ALL SEALANTS AND FIRE-STOPS SHALL BE SUBMITTED TO THE ARCHITECT FOR REVIEW PRIOR TO INSTALLATION.

Westfield
Working Drawing Review

B&W
PROJECT ADMINISTRATOR

#634 – EAGLE ROCK, CA
WESTFIELD SHOPPINGTOWN EAGLE ROCK
2700 COLORADO BLVD. SUITE 224
LOS ANGELES, CA 90041

CHUCK E. CHEESE'S

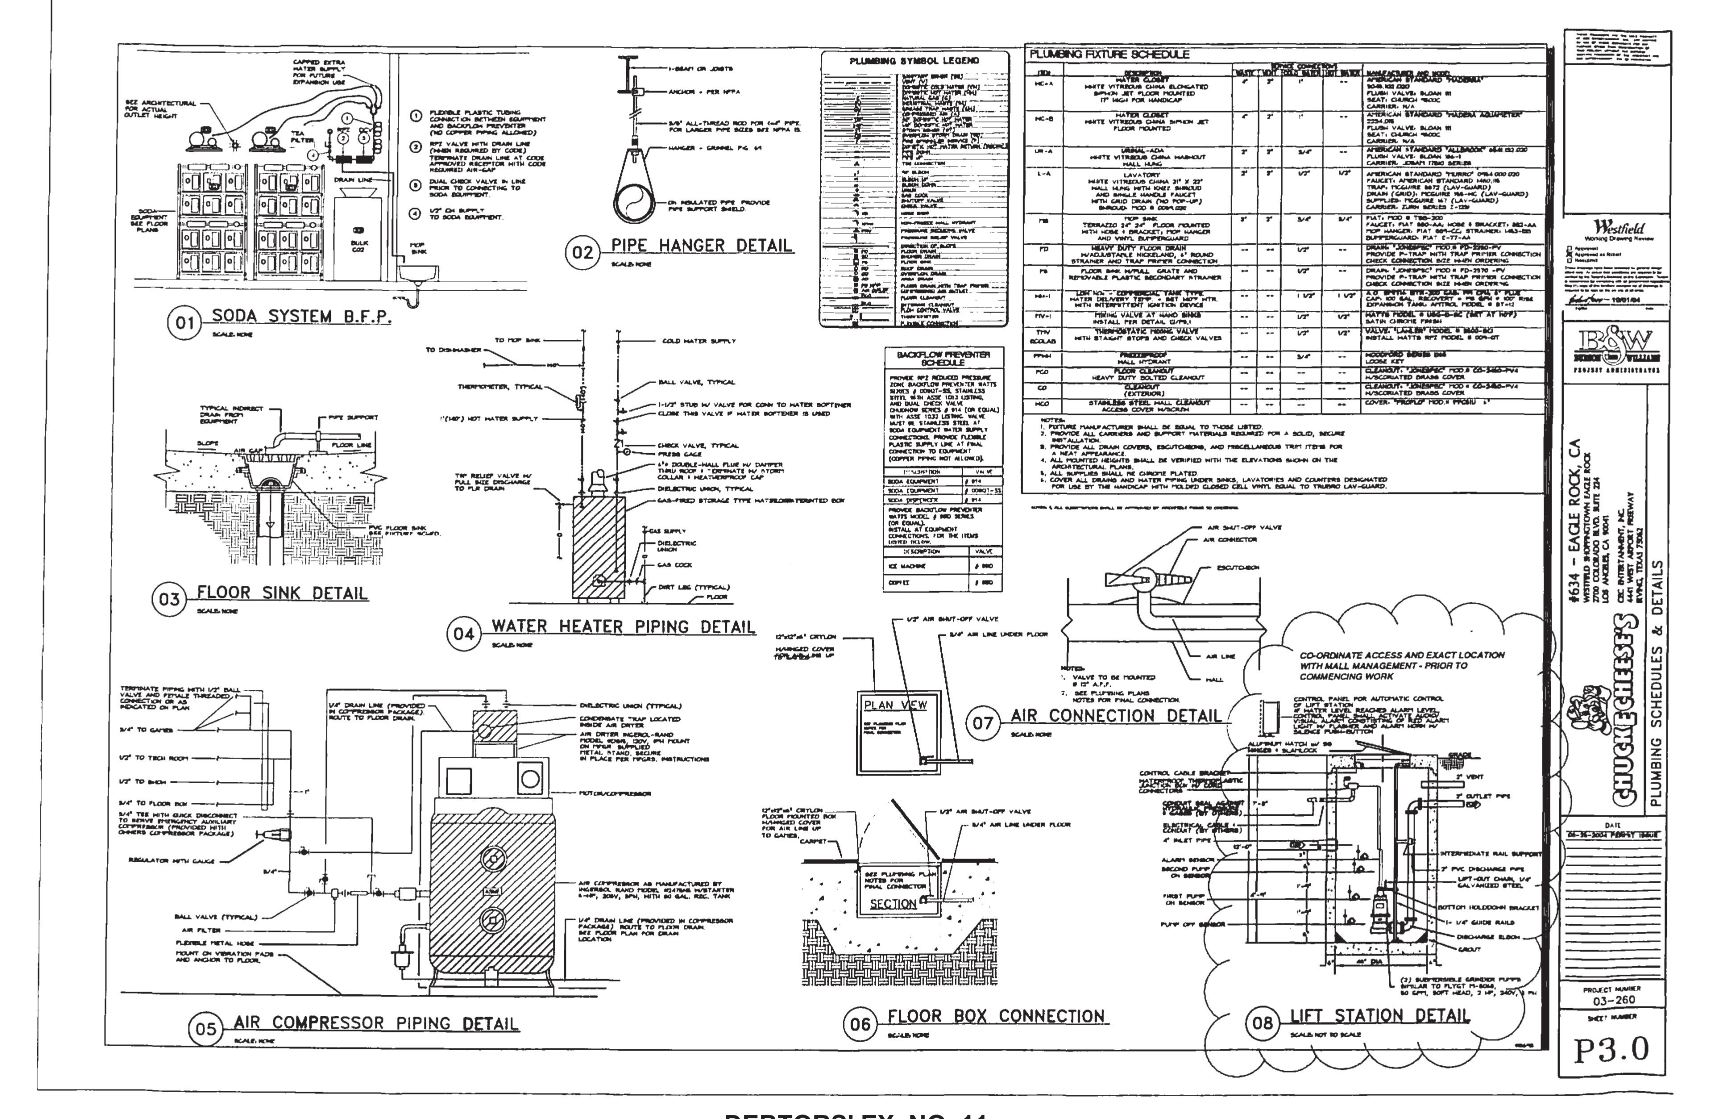
CEC ENTERTAINMENT, INC.
4441 WEST AIRPORT FREEWAY
IRVING, TEXAS 75062

ENLARGED KITCHEN PLUMBING PLAN

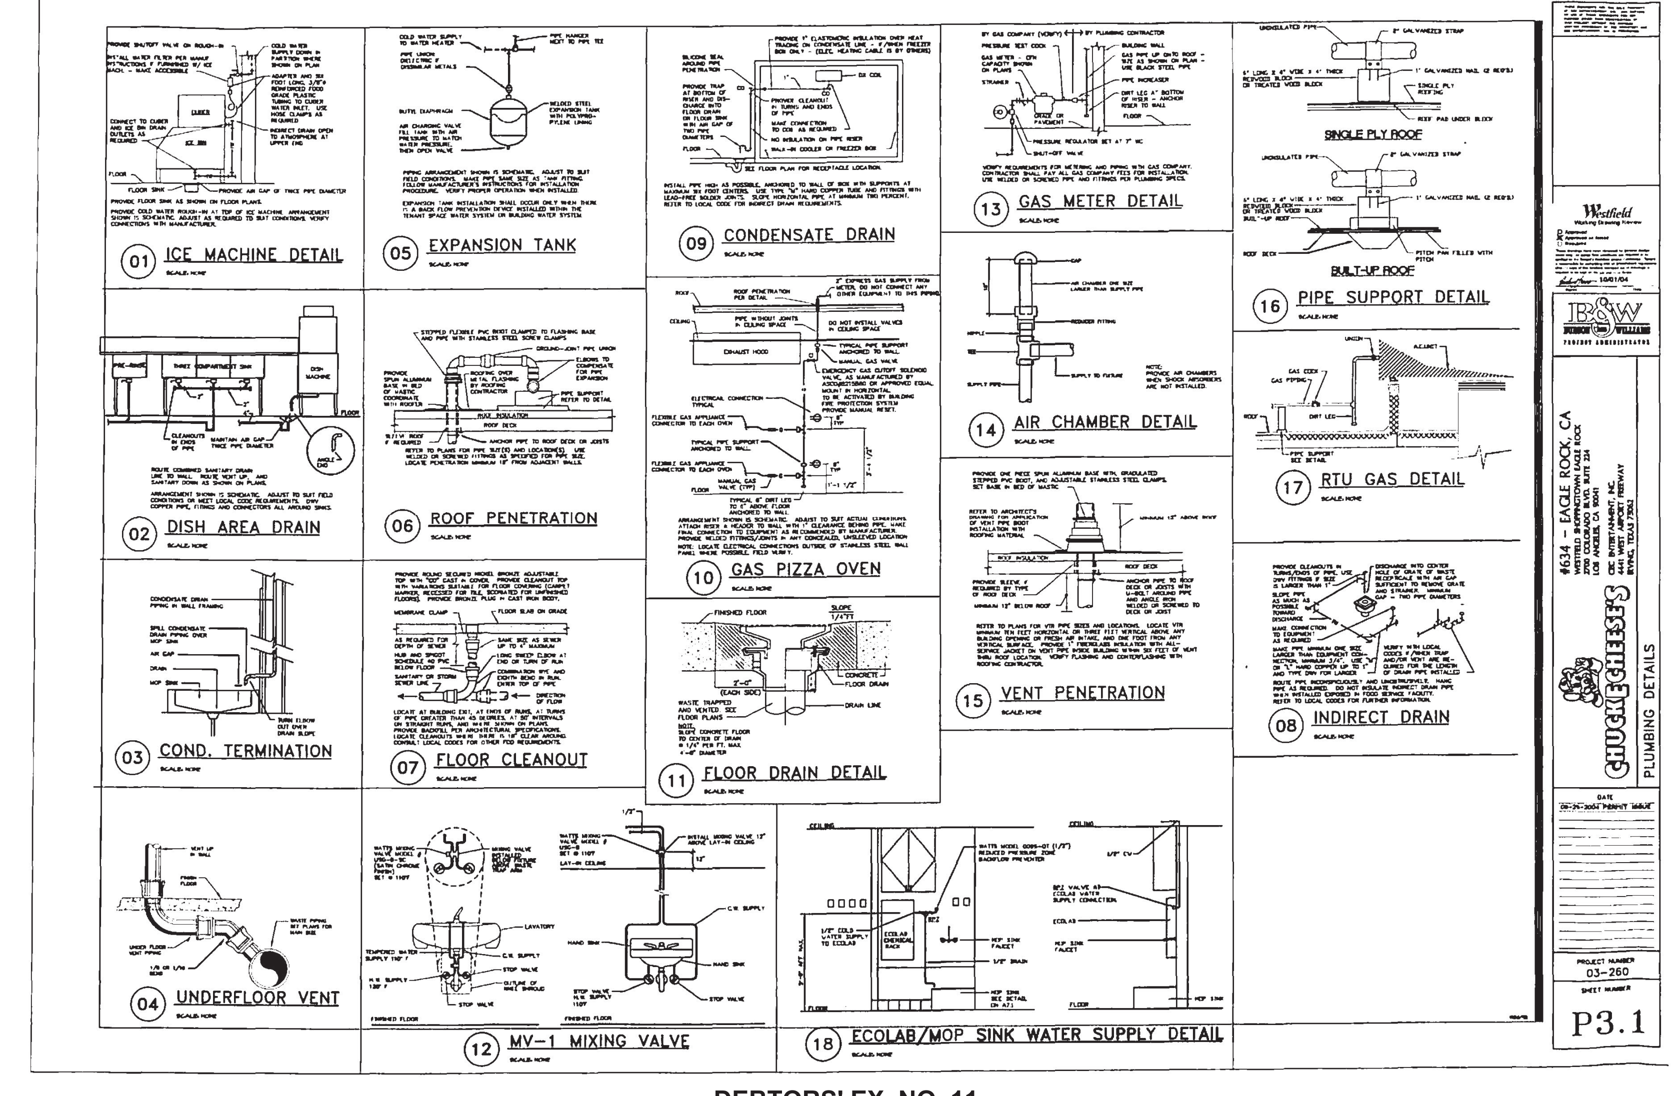
DATE
08-26-2004 PERMIT ISSUE

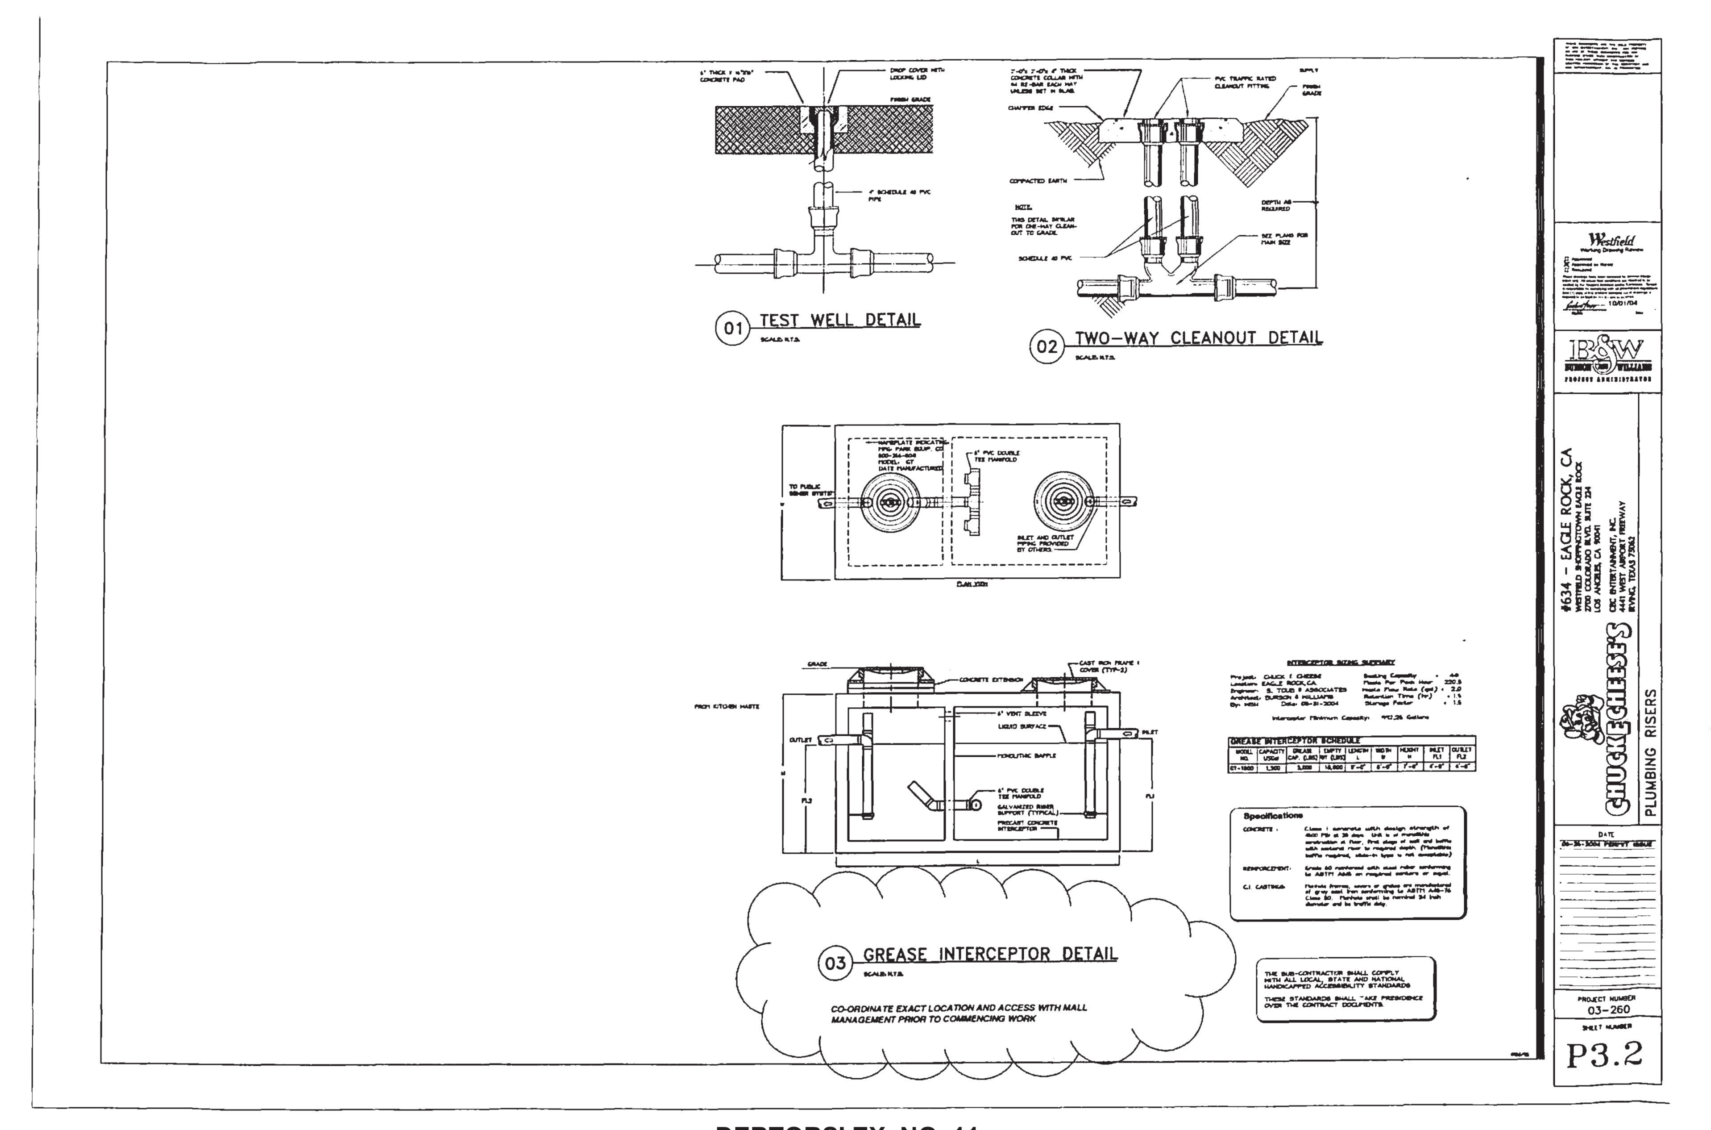
PROJECT NUMBER
03-260

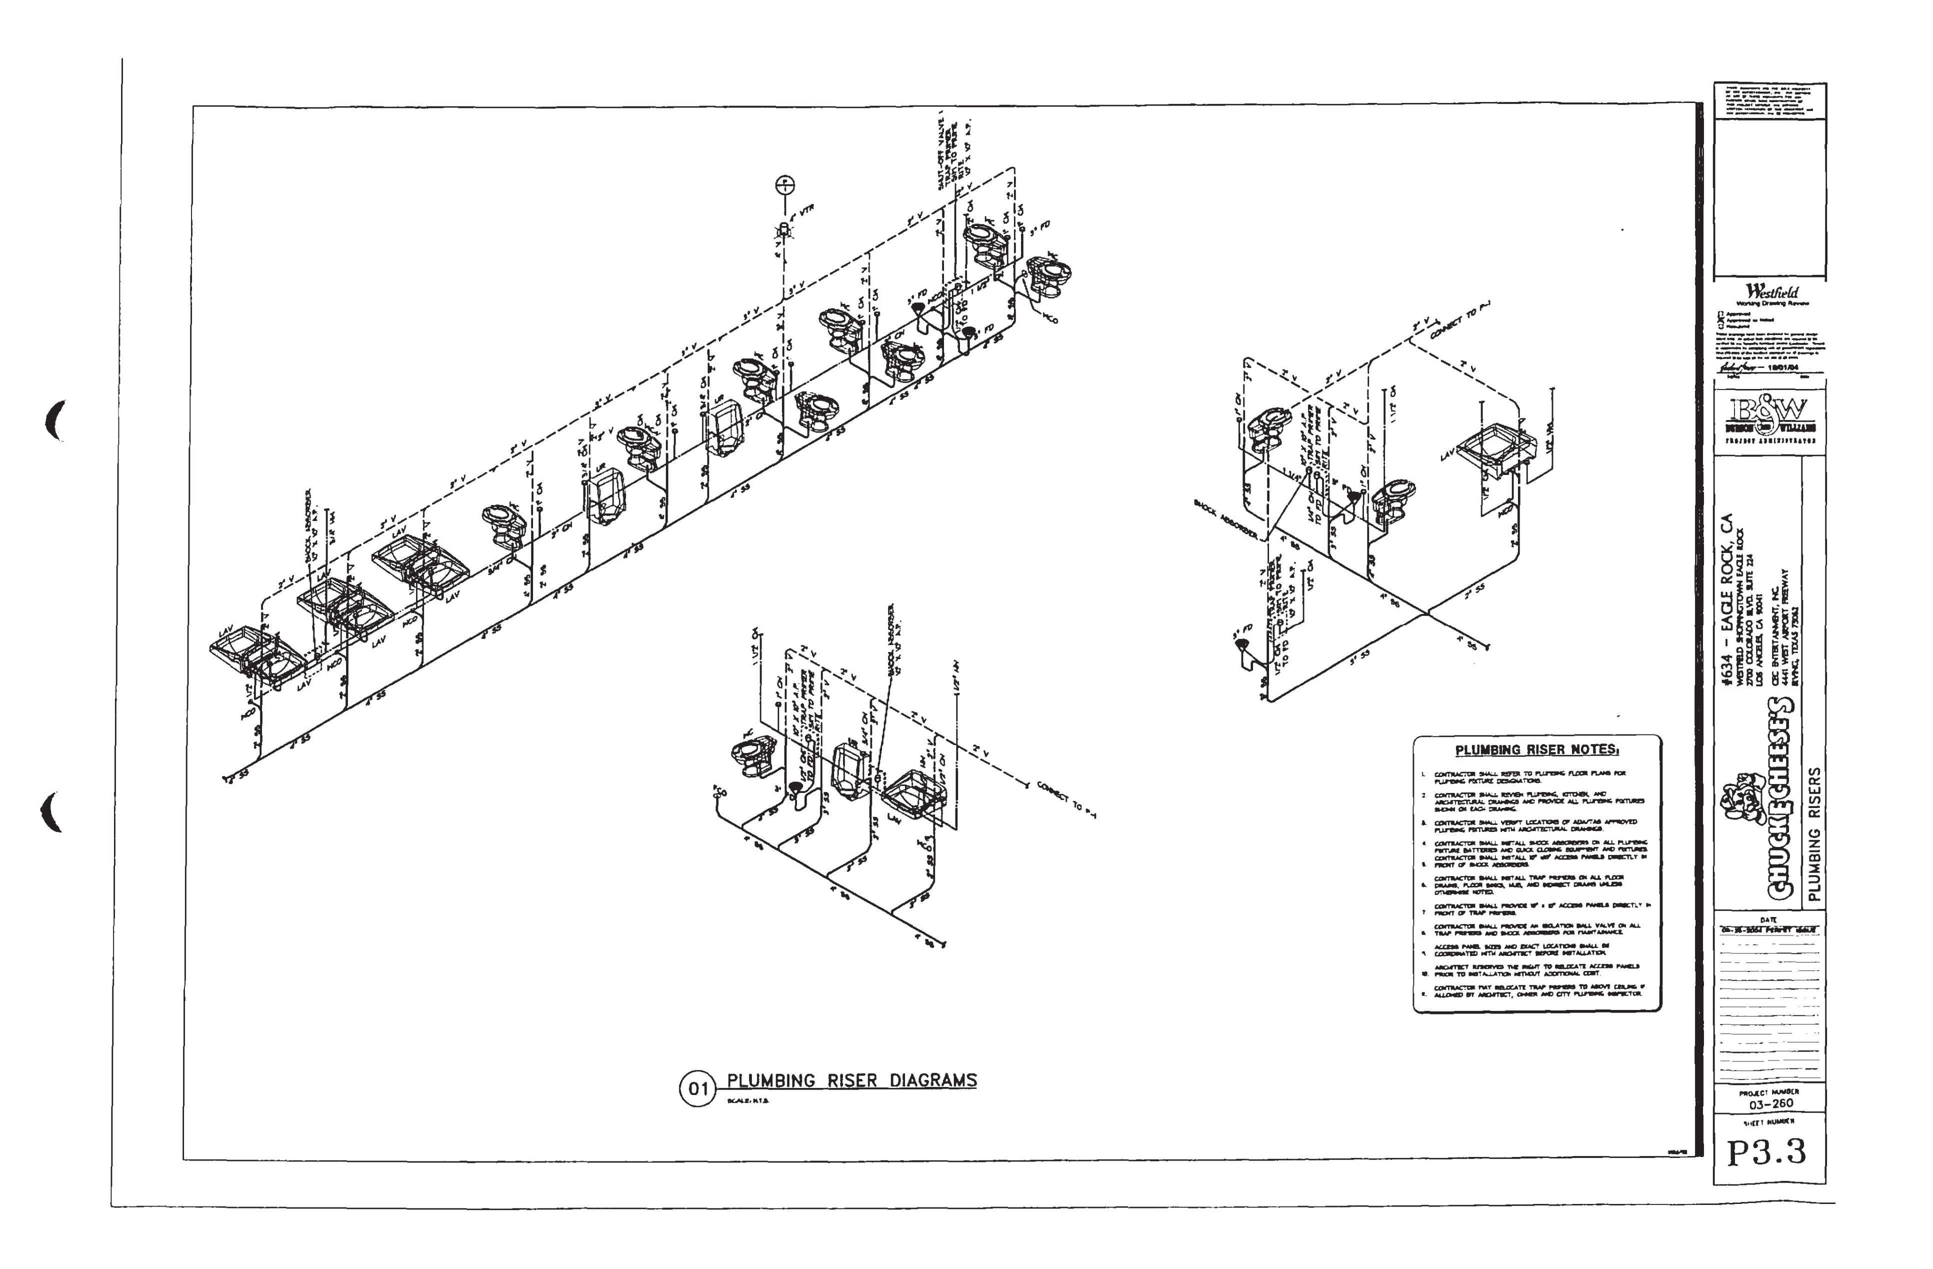
SHEET NUMBER
P2.1

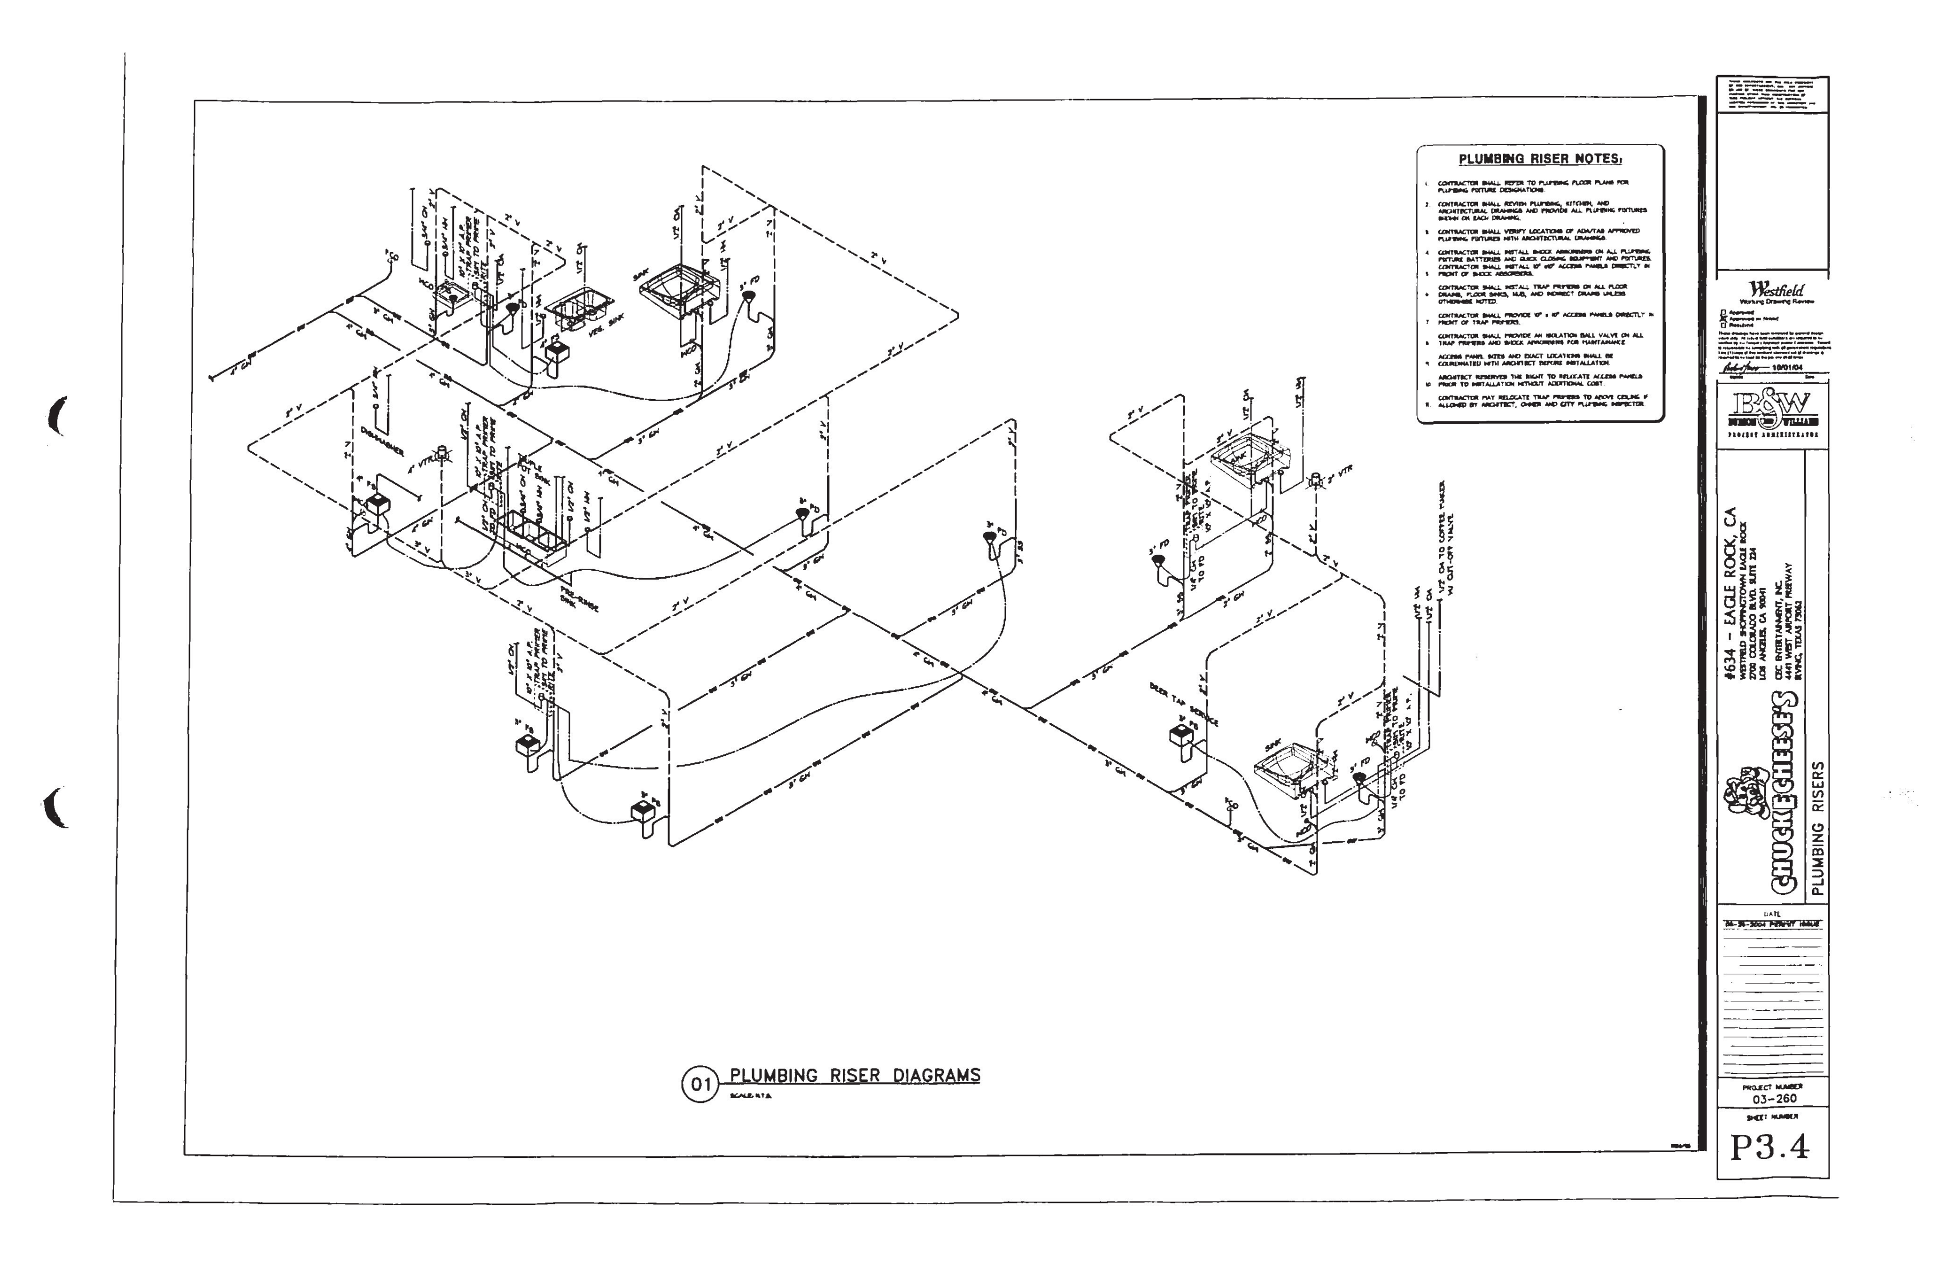


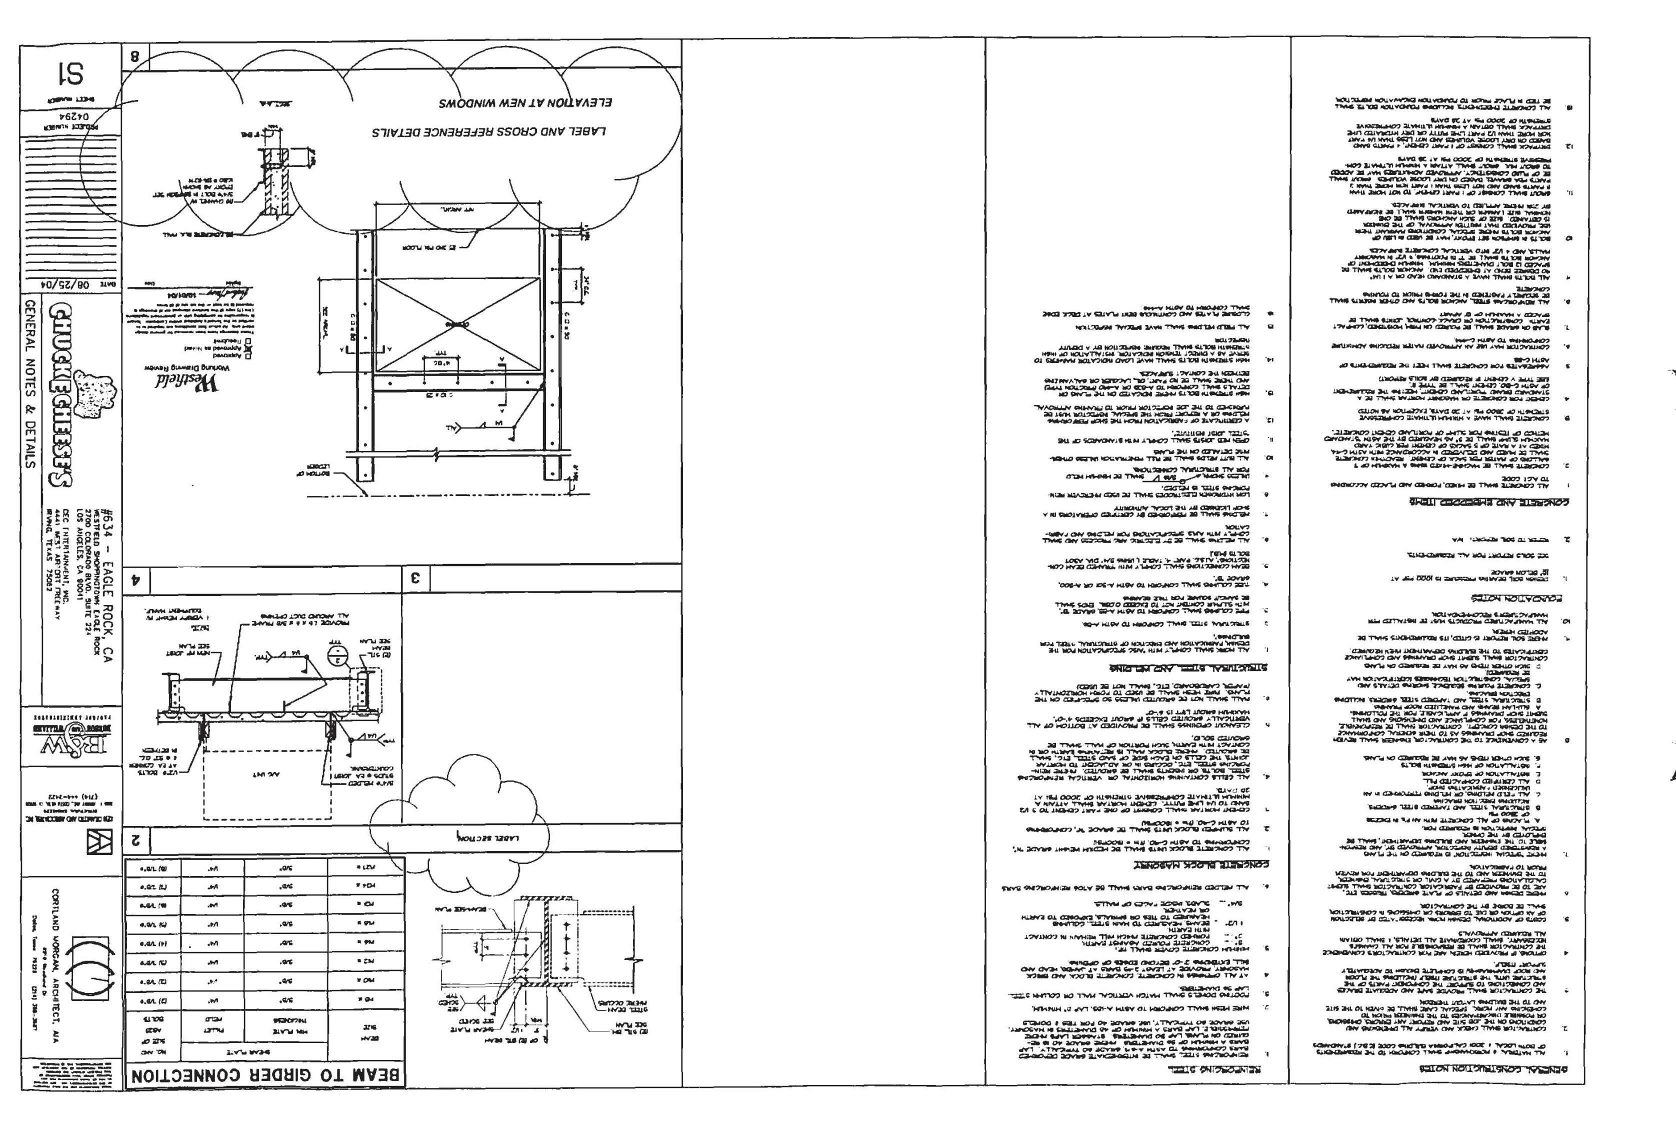
DEBTORS' EX. NO. 11
Page 121 of 130

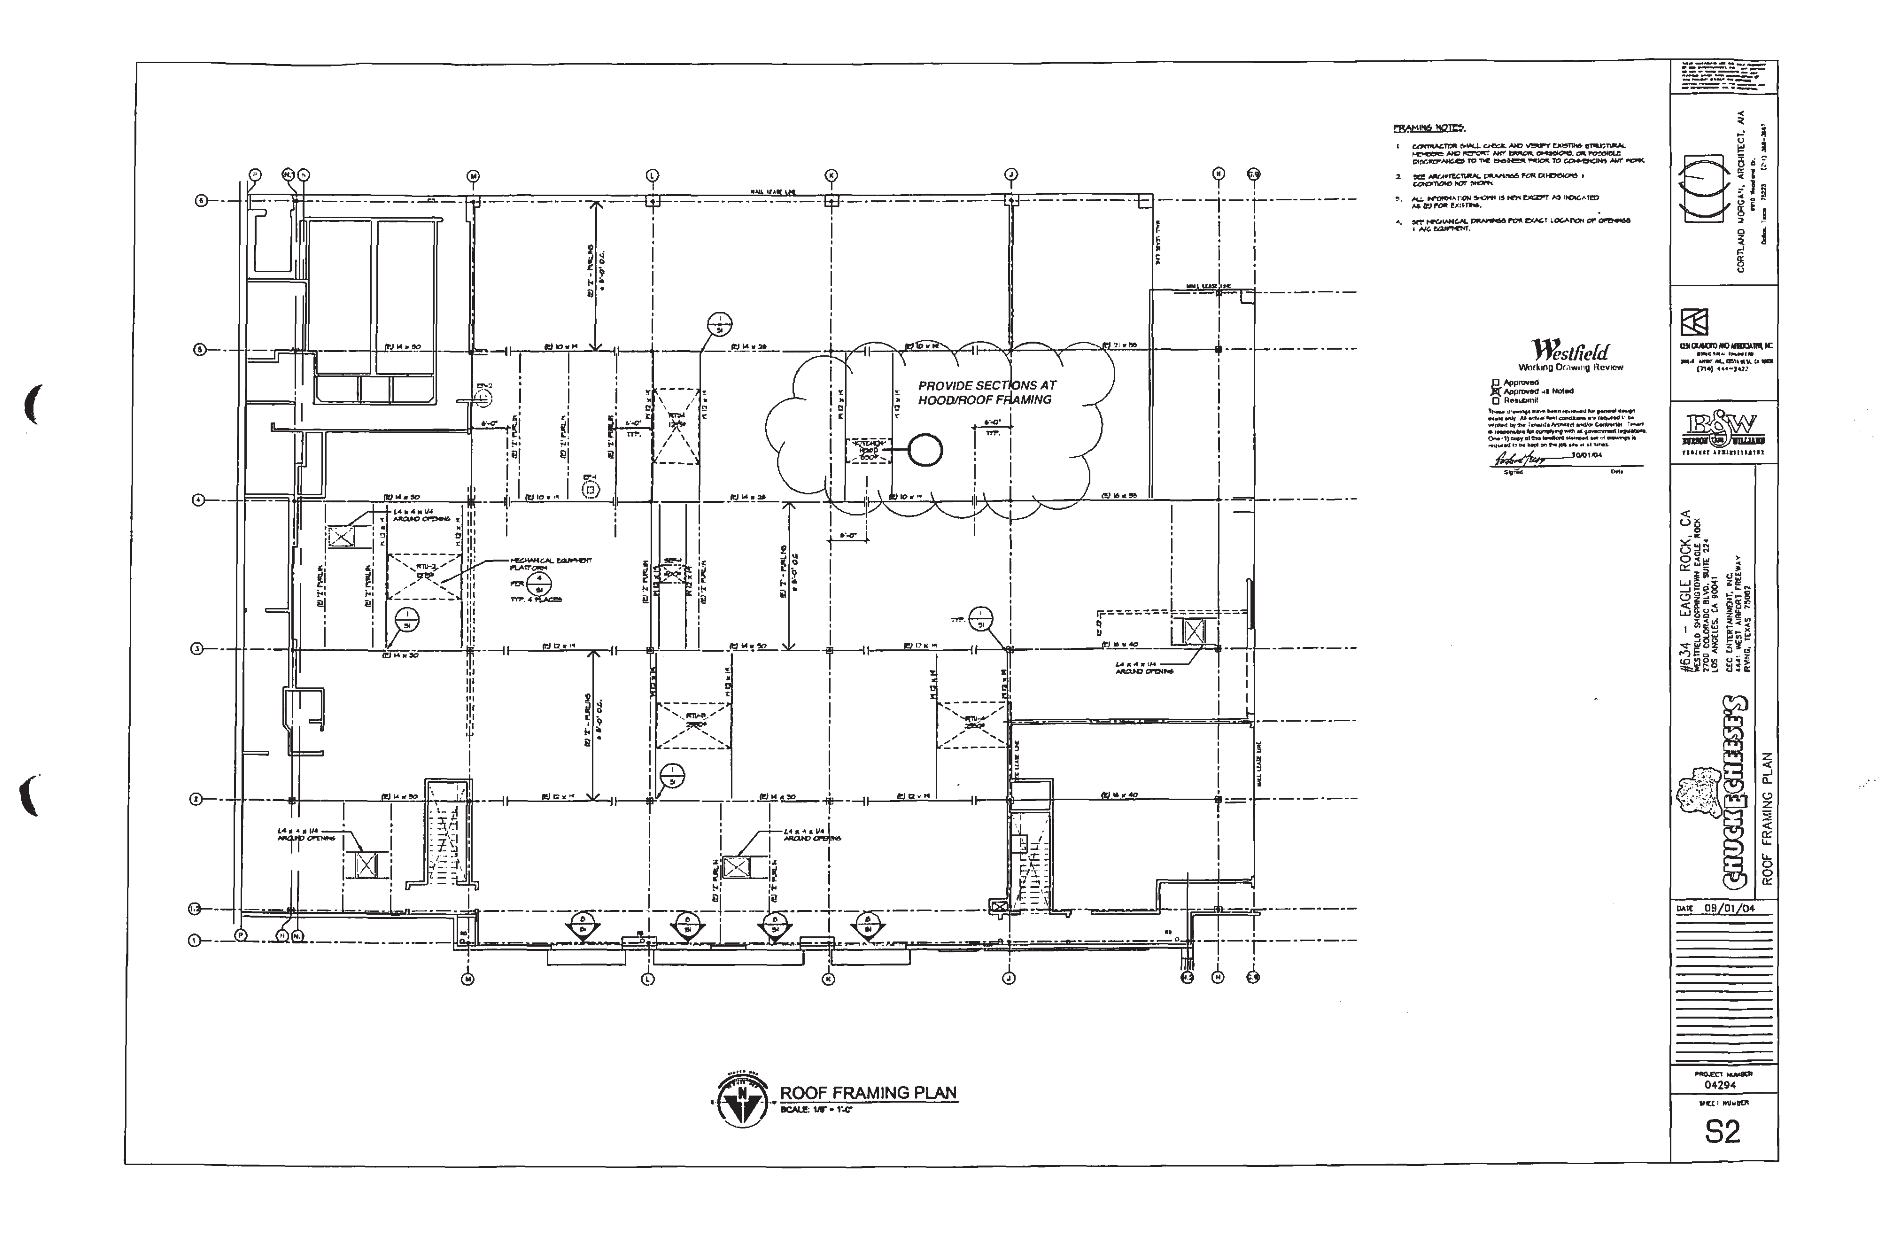

01 ICE MACHINE DETAIL
05 EXPANSION TANK
09 CONDENSATE DRAIN
13 GAS METER DETAIL
SINGLE PLY ROOF
BUILT-UP ROOF
16 PIPE SUPPORT DETAIL
02 DISH AREA DRAIN
06 ROOF PENETRATION
10 GAS PIZZA OVEN
14 AIR CHAMBER DETAIL
17 RTU GAS DETAIL
03 COND. TERMINATION
07 FLOOR CLEANOUT
11 FLOOR DRAIN DETAIL
15 VENT PENETRATION
08 INDIRECT DRAIN
04 UNDERFLOOR VENT
12 MV-1 MIXING VALVE
18 ECOLAB/MOP SINK WATER SUPPLY DETAIL
Westfield
B&W
#634 – EAGLE ROCK, CA
PLUMBING DETAILS
03-260
P3.1

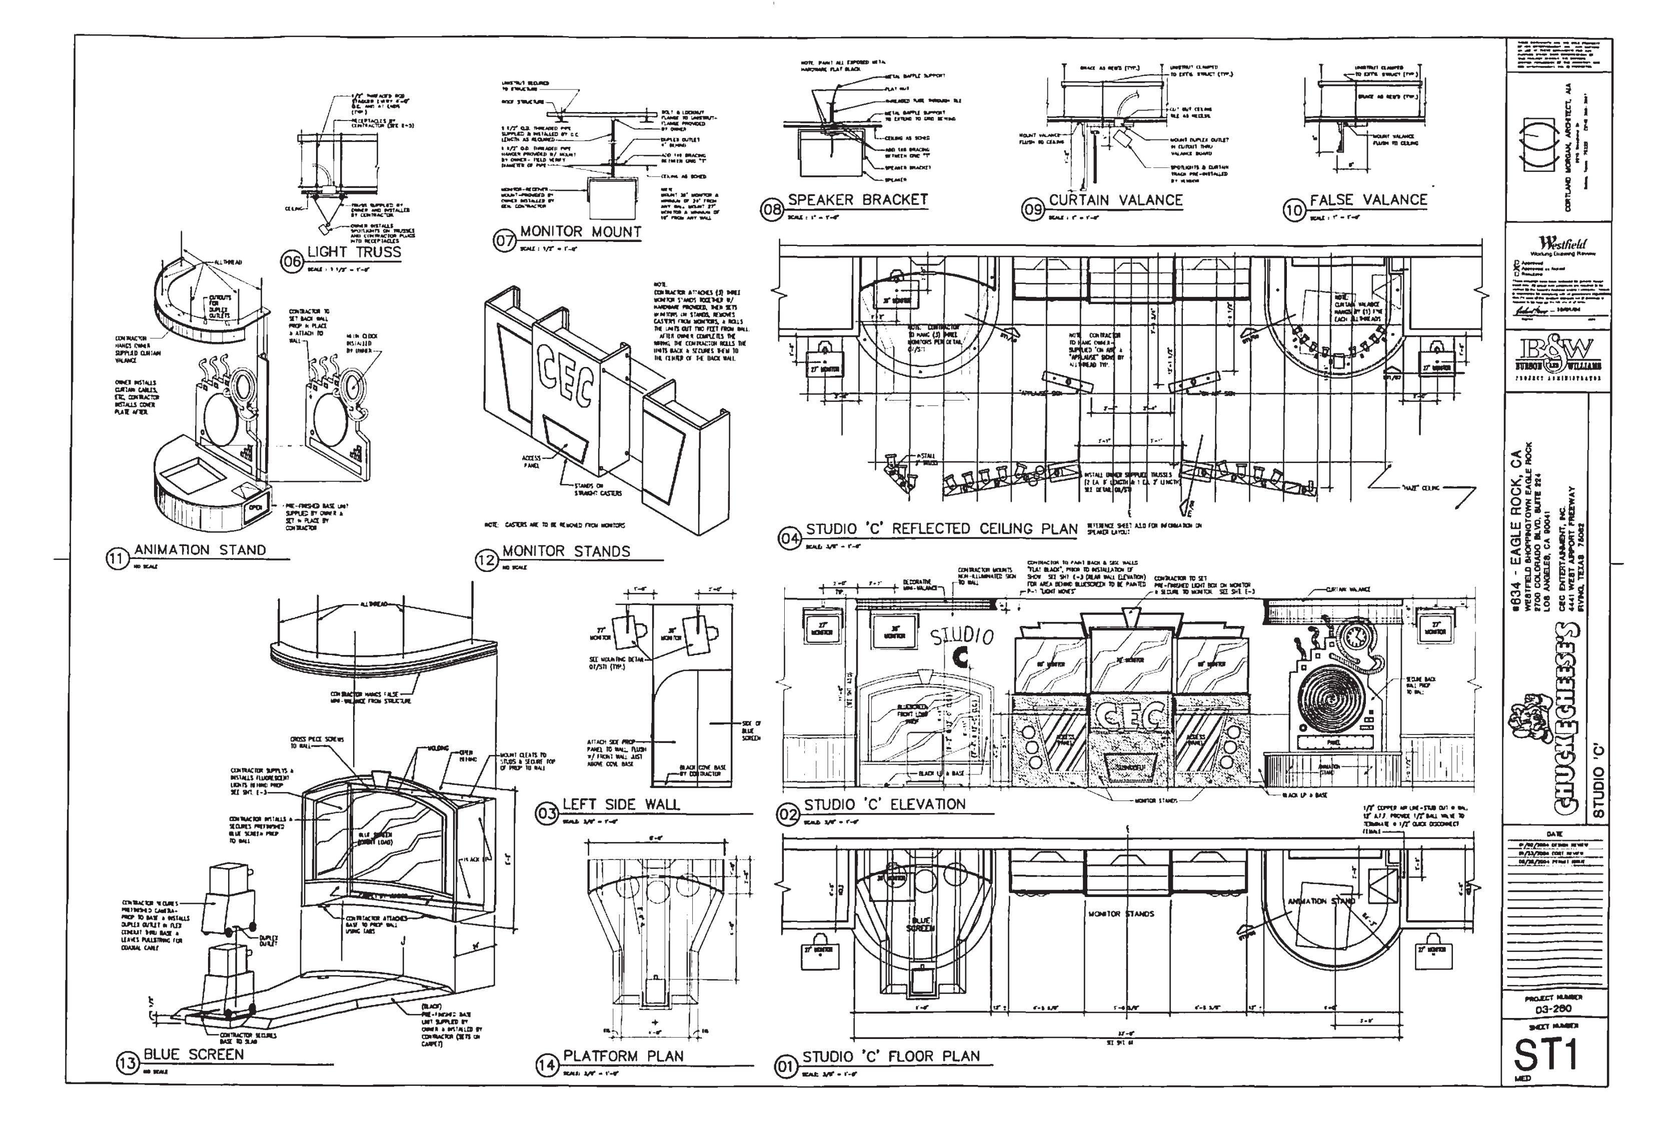

01 TEST WELL DETAIL
02 TWO-WAY CLEANOUT DETAIL
03 GREASE INTERCEPTOR DETAIL
CO-ORDINATE EXACT LOCATION AND ACCESS WITH MALL MANAGEMENT PRIOR TO COMMENCING WORK
Specifications
#634 - EAGLE ROCK, CA
PLUMBING RISERS
PROJECT NUMBER
03-260
SHEET NUMBER
P3.2


01 PLUMBING RISER DIAGRAMS
SCALE: N.T.S.
CONNECT TO P-1
SHUT-OFF VALVE / TRAP PRIMER
SHOCK ABSORBER
PLUMBING RISER NOTES:
1. CONTRACTOR SHALL REFER TO PLUMBING FLOOR PLANS FOR PLUMBING FIXTURE DESIGNATIONS.
2. CONTRACTOR SHALL REVIEW PLUMBING, KITCHEN, AND ARCHITECTURAL DRAWINGS AND PROVIDE ALL PLUMBING FIXTURES SHOWN ON EACH DRAWING.
3. CONTRACTOR SHALL VERIFY LOCATIONS OF ADA/TAS APPROVED PLUMBING FIXTURES WITH ARCHITECTURAL DRAWINGS.
4. CONTRACTOR SHALL INSTALL SHOCK ABSORBERS ON ALL PLUMBING FIXTURE BATTERIES AND QUICK CLOSING EQUIPMENT AND FIXTURES.
5. CONTRACTOR SHALL INSTALL ACCESS PANELS DIRECTLY IN FRONT OF SHOCK ABSORBERS.
6. CONTRACTOR SHALL INSTALL TRAP PRIMERS ON ALL FLOOR DRAINS, FLOOR SINKS, HUB, AND INDIRECT DRAINS UNLESS OTHERWISE NOTED.
7. CONTRACTOR SHALL PROVIDE ACCESS PANELS DIRECTLY IN FRONT OF TRAP PRIMERS.
8. CONTRACTOR SHALL PROVIDE AN ISOLATION BALL VALVE ON ALL TRAP PRIMERS AND SHOCK ABSORBERS FOR MAINTAINANCE.
9. ACCESS PANEL SIZES AND EXACT LOCATIONS SHALL BE COORDINATED WITH ARCHITECT BEFORE INSTALLATION.
10. ARCHITECT RESERVES THE RIGHT TO RELOCATE ACCESS PANELS PRIOR TO INSTALLATION WITHOUT ADDITIONAL COST.
11. CONTRACTOR MAY RELOCATE TRAP PRIMERS TO ABOVE CEILING IF ALLOWED BY ARCHITECT, OWNER AND CITY PLUMBING INSPECTOR.
#634 - EAGLE ROCK, CA
WESTFIELD SHOPPINGTOWN EAGLE ROCK
2700 COLORADO BLVD. SUITE 224
LOS ANGELES, CA 90041
CEC ENTERTAINMENT, INC.
4441 WEST AIRPORT FREEWAY
IRVING, TEXAS 75062
CHUCK E CHEESE'S
PLUMBING RISERS
Westfield
Working Drawing Review
B&W
PROJECT NUMBER
03-260
SHEET NUMBER
P3.3


PLUMBING RISER NOTES:
1. CONTRACTOR SHALL REFER TO PLUMBING FLOOR PLANS FOR PLUMBING FIXTURE DESIGNATIONS.
2. CONTRACTOR SHALL REVIEW PLUMBING, KITCHEN, AND ARCHITECTURAL DRAWINGS AND PROVIDE ALL PLUMBING FIXTURES SHOWN ON EACH DRAWING.
3. CONTRACTOR SHALL VERIFY LOCATIONS OF ADA/TAS APPROVED PLUMBING FIXTURES WITH ARCHITECTURAL DRAWINGS.
4. CONTRACTOR SHALL INSTALL SHOCK ABSORBERS ON ALL PLUMBING FIXTURE BATTERIES AND QUICK CLOSING EQUIPMENT AND FIXTURES.
5. CONTRACTOR SHALL INSTALL 10" x10" ACCESS PANELS DIRECTLY IN FRONT OF SHOCK ABSORBERS.
6. CONTRACTOR SHALL INSTALL TRAP PRIMERS ON ALL FLOOR DRAINS, FLOOR SINKS, HUB, AND INDIRECT DRAINS UNLESS OTHERWISE NOTED.
7. CONTRACTOR SHALL PROVIDE 10" x 10" ACCESS PANELS DIRECTLY IN FRONT OF TRAP PRIMERS.
8. CONTRACTOR SHALL PROVIDE AN ISOLATION BALL VALVE ON ALL TRAP PRIMERS AND SHOCK ABSORBERS FOR MAINTAINANCE.
9. ACCESS PANEL SIZES AND EXACT LOCATIONS SHALL BE COORDINATED WITH ARCHITECT BEFORE INSTALLATION.
10. ARCHITECT RESERVES THE RIGHT TO RELOCATE ACCESS PANELS PRIOR TO INSTALLATION WITHOUT ADDITIONAL COST.
11. CONTRACTOR MAY RELOCATE TRAP PRIMERS TO ABOVE CEILING IF ALLOWED BY ARCHITECT, OWNER AND CITY PLUMBING INSPECTOR.
DISHWASHER
PRE-RINSE SINK
VEG. SINK
SINK
BEER TAP SERVICE
1/2" CW TO COFFEE MAKER W/ OUT-OFF VALVE
01 PLUMBING RISER DIAGRAMS
SCALE: N.T.S.
Westfield
Working Drawing Review
B&W BURSON WILLIAMS
PROJECT ADMINISTRATORS
#634 – EAGLE ROCK, CA
WESTFIELD SHOPPINGTOWN EAGLE ROCK
2700 COLORADO BLVD. SUITE 224
LOS ANGELES, CA 90041
CEC ENTERTAINMENT, INC.
4441 WEST AIRPORT FREEWAY
IRVING, TEXAS 75062
CHUCK E CHEESE'S
PLUMBING RISERS
DATE
PROJECT NUMBER
03-260
SHEET NUMBER
P3.4


GENERAL CONSTRUCTION NOTES
FOUNDATION NOTES
CONCRETE AND EMBEDDED ITEMS
REINFORCING STEEL
CONCRETE BLOCK MASONRY
STRUCTURAL STEEL AND WELDING
BEAM TO GIRDER CONNECTION
LABEL SECTION
LABEL AND CROSS REFERENCE DETAILS
ELEVATION AT NEW WINDOWS
Westfield
Working Drawing Review
CORTLAND MORGAN, ARCHITECT, AIA
#634 - EAGLE ROCK, CA
WESTFIELD SHOPPINGTOWN EAGLE ROCK
2700 COLORADO BLVD. SUITE 224
LOS ANGELES, CA 90041
CEC ENTERTAINMENT, INC.
4441 WEST AIRPORT FREEWAY
IRVING, TEXAS 75062
CHUCK E CHEESE'S
GENERAL NOTES & DETAILS
DATE 08/25/04
PROJECT NUMBER 04294
S1


ROOF FRAMING PLAN
SCALE: 1/8" = 1'-0"
PROVIDE SECTIONS AT HOOD/ROOF FRAMING
Westfield
Working Drawing Review
CHUCK E. CHEESE'S
#634 - EAGLE ROCK, CA
WESTFIELD SHOPPINGTOWN EAGLE ROCK
2700 COLORADO BLVD. SUITE 224
LOS ANGELES, CA 90041
CEC ENTERTAINMENT, INC.
4441 WEST AIRPORT FREEWAY
IRVING, TEXAS 75062
ROOF FRAMING PLAN
DATE 09/01/04
CORTLAND MORGAN, ARCHITECT, AIA
S2


06 LIGHT TRUSS
07 MONITOR MOUNT
08 SPEAKER BRACKET
09 CURTAIN VALANCE
10 FALSE VALANCE
11 ANIMATION STAND
12 MONITOR STANDS
04 STUDIO 'C' REFLECTED CEILING PLAN
CEC
STUDIO C
03 LEFT SIDE WALL
02 STUDIO 'C' ELEVATION
13 BLUE SCREEN
14 PLATFORM PLAN
01 STUDIO 'C' FLOOR PLAN
MONITOR STANDS
ANIMATION STAND
BLUE SCREEN
CORTLAND MORGAN, ARCHITECT, AIA
Westfield
B&W
#634 - EAGLE ROCK, CA
WESTFIELD SHOPPINGTOWN EAGLE ROCK
2700 COLORADO BLVD, SUITE 224
LOS ANGELES, CA 90041
CEC ENTERTAINMENT, INC.
4441 WEST AIRPORT FREEWAY
IRVING, TEXAS 75062
CHUCK E. CHEESE'S
STUDIO 'C'
DATE
PROJECT NUMBER
03-260
SHEET NUMBER
ST1